


GEORGE T. DUNHAM
SURVEYING & SUBDIVIDING
DELAVAN, WISCONSIN

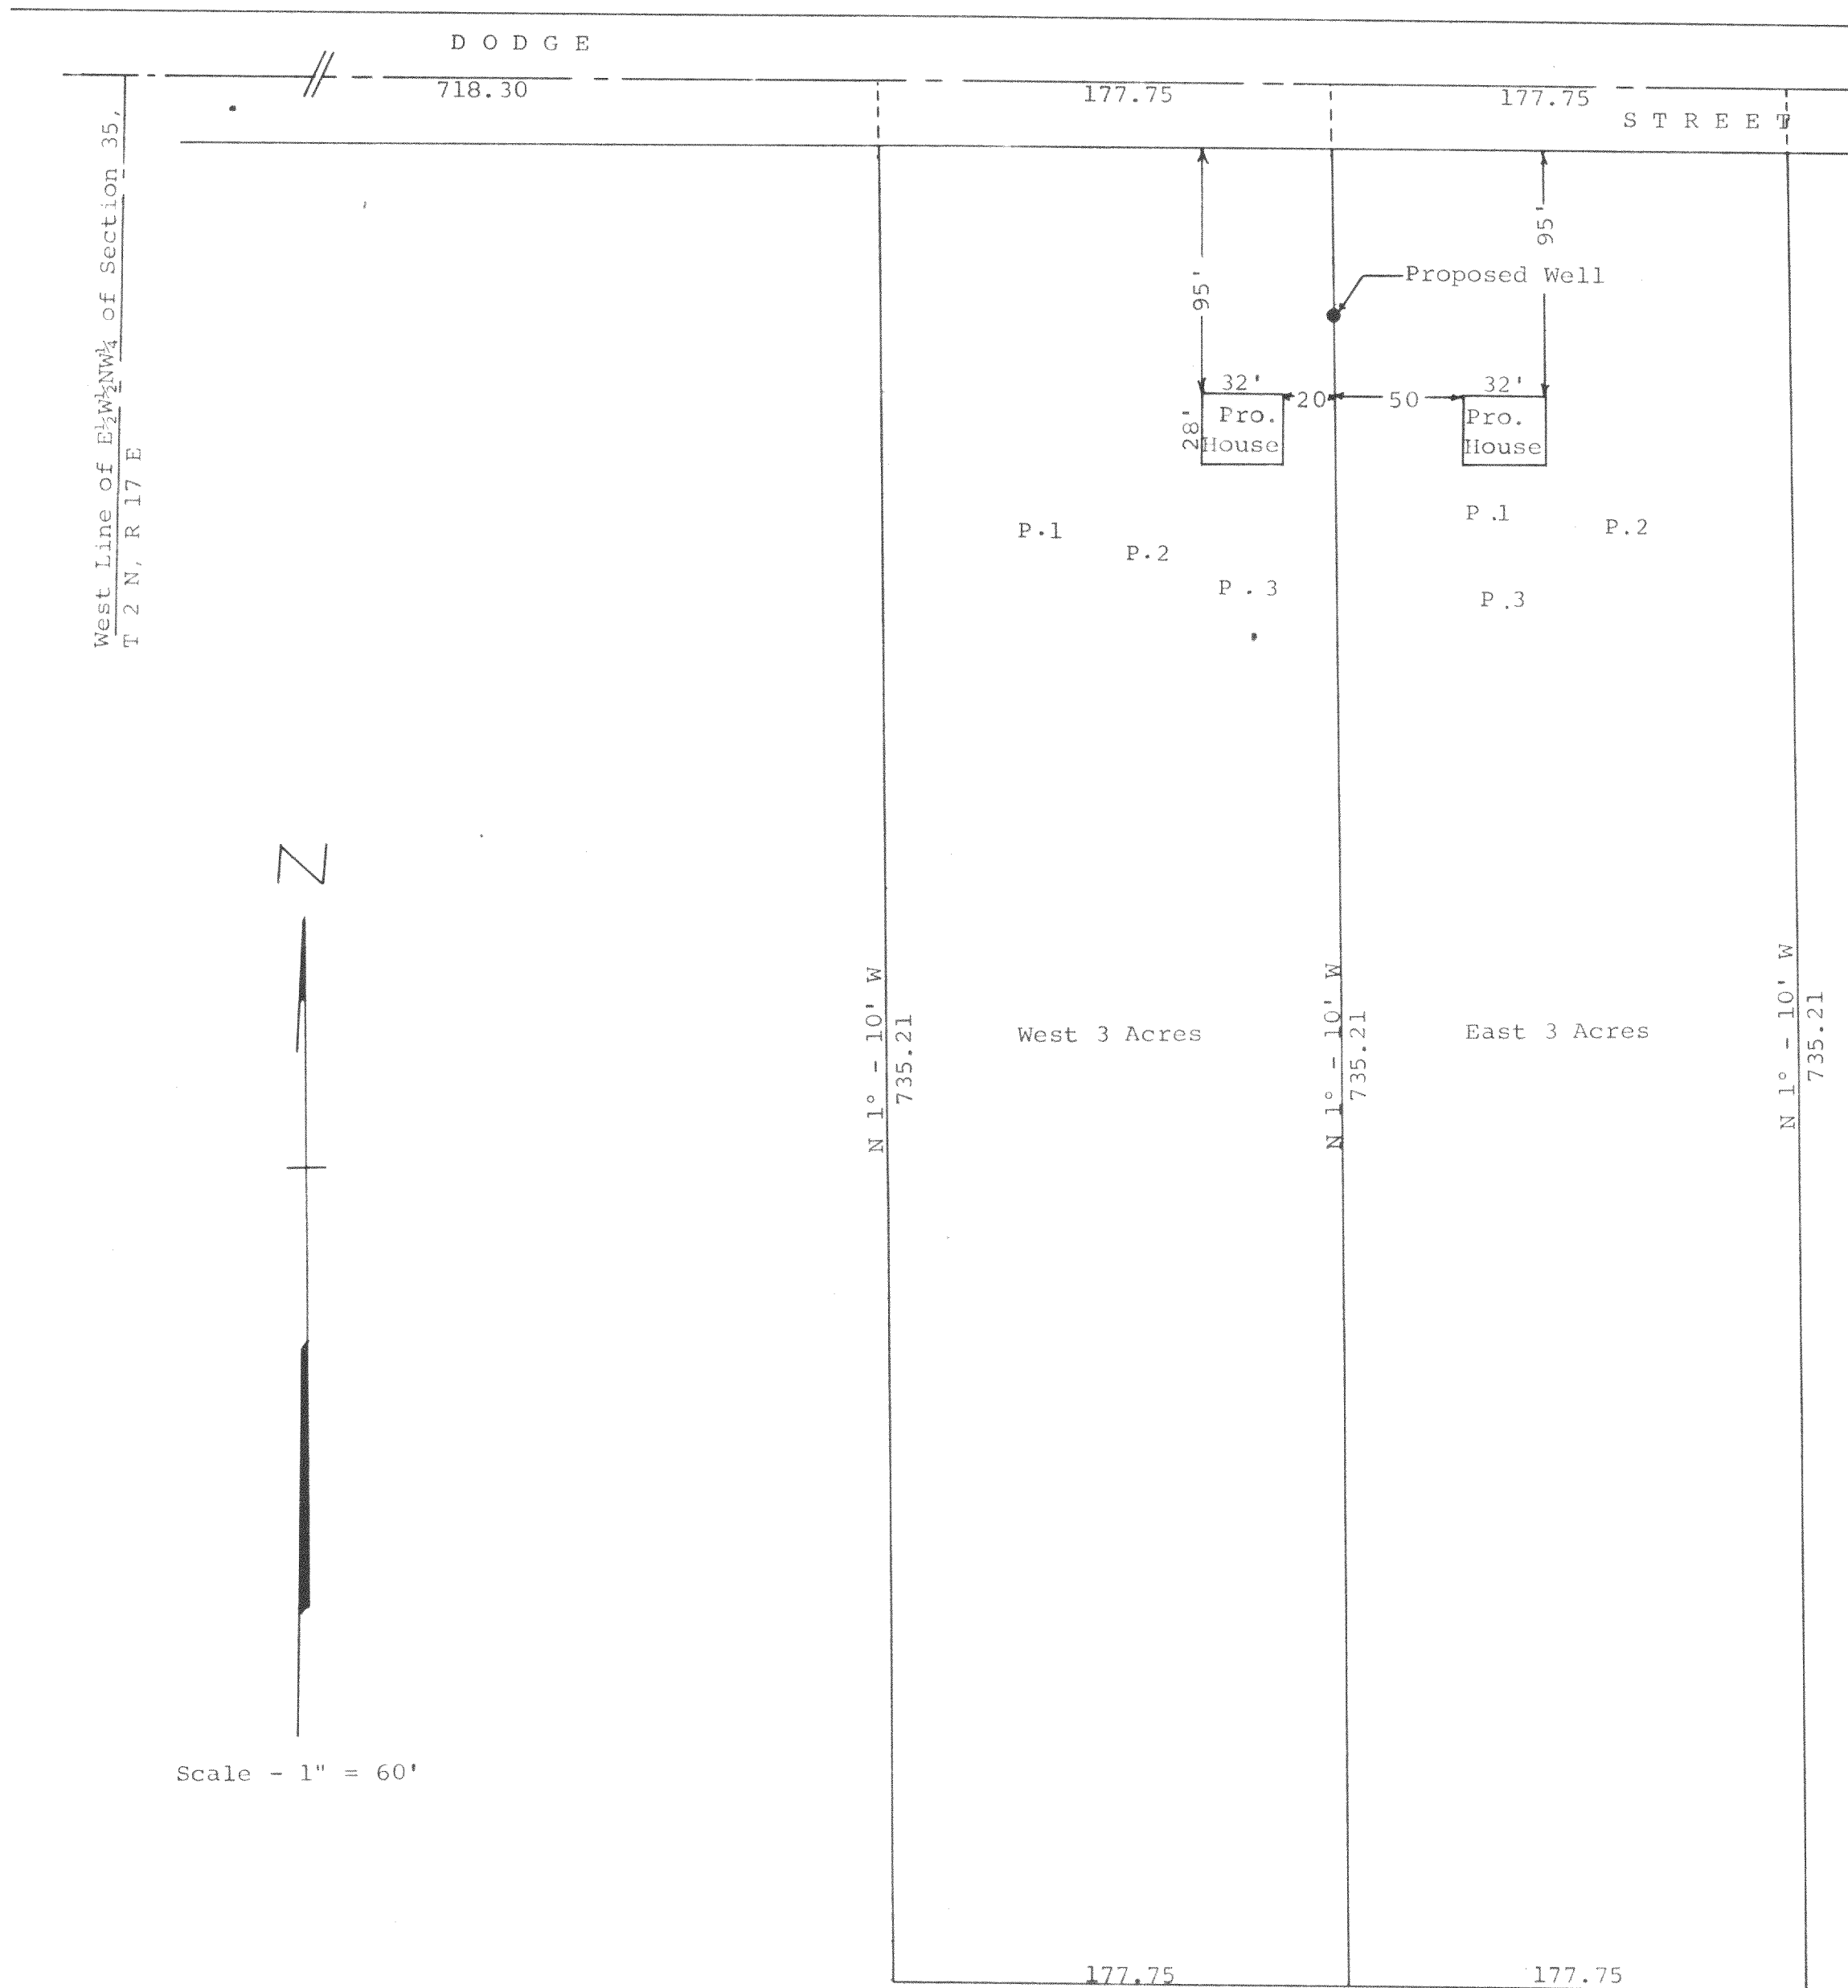

Plat showing the location of the percolation tests made on property owned by Walter Swanson located in the Northwest $\frac{1}{4}$ of Section 35, T 2 N, R 17 E, Walworth County, Wisconsin.
August 3, 1967

George T. Dunham
George T. Dunham, Surveyor

G-35-5
" 5U