

WALWORTH COUNTY  
SURVEYING & MAPPING  
727 HENRY STREET  
LAKE GENEVA, WISCONSIN  
414-248-0505

LOT 1

MARSHALL LANE

LOT 2

RESIDENCE

GRAVEL DRIVEWAY

LOT 3

PLAT OF SURVEY OF

LOT 2 OF CERTIFIED SURVEY MAP NO. 660, LOCATED  
IN SECTION 26, T 2 N, R 17 E, WALWORTH COUNTY,  
WISCONSIN.

ORDERED BY: REX NEWCOMB  
RT. 4, BOX 230  
LAKE GENEVA, WISCONSIN  
53147

I HEREBY CERTIFY THAT I HAVE SURVEYED THE ABOVE DESCRIBED  
PROPERTY AND THAT THE ABOVE MAP IS A TRUE REPRESENTATION  
THEREOF AND SHOWS THE SIZE AND LOCATION OF THE PROPERTY,  
ITS EXTERIOR BOUNDARIES, THE LOCATION OF ALL VISIBLE STRUCTURES  
AND DIMENSIONS OF ALL PRINCIPAL BUILDINGS THEREON, BOUNDARY  
FENCES, APPARENT EASEMENTS, ROADWAYS AND VISIBLE ENCROACH-  
MENTS, IF ANY, TO THE BEST OF MY KNOWLEDGE AND BELIEF.


THIS SURVEY IS MADE FOR THE USE OF THE PRESENT OWNERS OF  
THE PROPERTY AND ALSO THOSE WHO PURCHASE, MORTGAGE OR  
QUARANTEE THE TITLE THERETO WITHIN ONE (1) YEAR FROM DATE  
HEREOF.

*Robert M. Baerenwald*  
ROBERT M. BAERENWALD  
WISCONSIN REGISTERED LAND SURVEYOR, S-1508

DATE April 1, 1991 JOB NO. 2849

NOTE: THIS IS NOT A CERTIFIED COPY UNLESS SEALED.


- LEGEND
- Ø-IRON PIPE FOUND
  - Ø-IRON ROD FOUND
  - CONCRETE MONUMENT FOUND
  - IRON PIPE PLACED
  - ( )-RECORDED AS

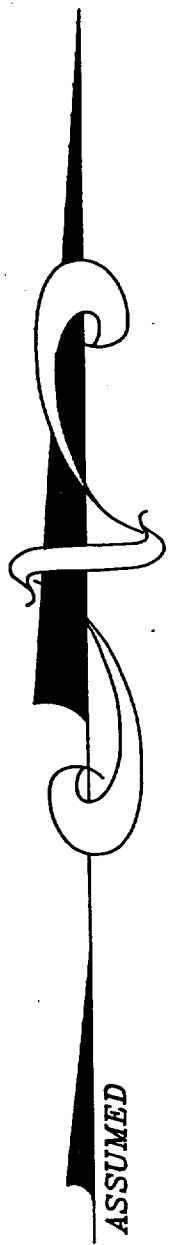

GRAPHIC SCALE



( IN FEET )  
1 inch = 30 ft.

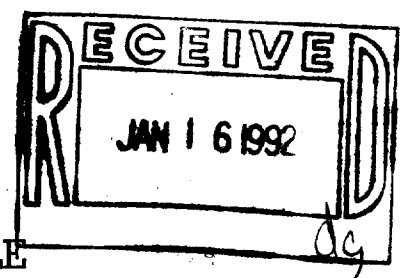

217-1008

JA-660-2