

414-728-6737



### LEGEND

● - IRON ROD FOUND  
( ) - RECORDED AS

NOTE: BEARINGS ARE REFERENCED TO THE  
RECORDED CONDOMINIUM PLAT.

UNIT 15-08

UNIT 15-07

UNIT 15-09

N 31° 38' 57" E


[illegible]

**NATIONAL**  
**PRIVATE**

AVENUE

# PLAT OF SURVEY OF

UNIT 15-08. GENEVA NATIONAL CONDOMINIUM  
NO. 15. LOCATED IN T2N. R17E. WALWORTH  
COUNTY, WISCONSIN.

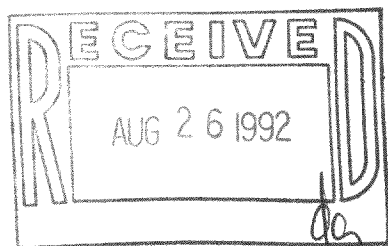

ORDERED BY: ANCHOR SAVINGS & LOAN  
P.O. BOX 997  
LAKE GENEVA, WI. 53147

I HEREBY CERTIFY THAT I HAVE SURVEYED THE ABOVE DESCRIBED PROPERTY AND THAT THE ABOVE MAP IS A TRUE REPRESENTATION THEREOF AND SHOWS THE SIZE AND LOCATION OF THE PROPERTY, ITS EXTERIOR BOUNDARIES, THE LOCATION OF ALL VISIBLE STRUCTURES AND DIMENSIONS OF ALL PRINCIPAL BUILDINGS THEREON, BOUNDARY FENCES, APPARENT EASEMENTS, ROADWAYS AND VISIBLE ENCROACHMENTS, IF ANY, TO THE BEST OF MY KNOWLEDGE AND BELIEF.

THIS SURVEY IS MADE FOR THE USE OF THE PRESENT OWNERS OF THE PROPERTY, AND ALSO THOSE WHO PURCHASE, MORTGAGE, OR GUARANTEE THE TITLE THERETO WITHIN ONE (1) YEAR FROM DATE HEREON.

David F. Abell

DAVID F. ABELL  
WISCONSIN REGISTERED LAND SURVEYOR, S-1596

JUNE 15, 1992

DATE \_\_\_\_\_ JOB NUMBER - 92121  
NOTE: THIS IS NOT A CERTIFIED COPY UNLESS SEALED.

217-1060

JGN-15-8