


KOLB LAND CONSULTING, INC.
LAND SURVEYING • SUBDIVIDING • LAND PLANNING

LAKE GENEVA, WISCONSIN 53147

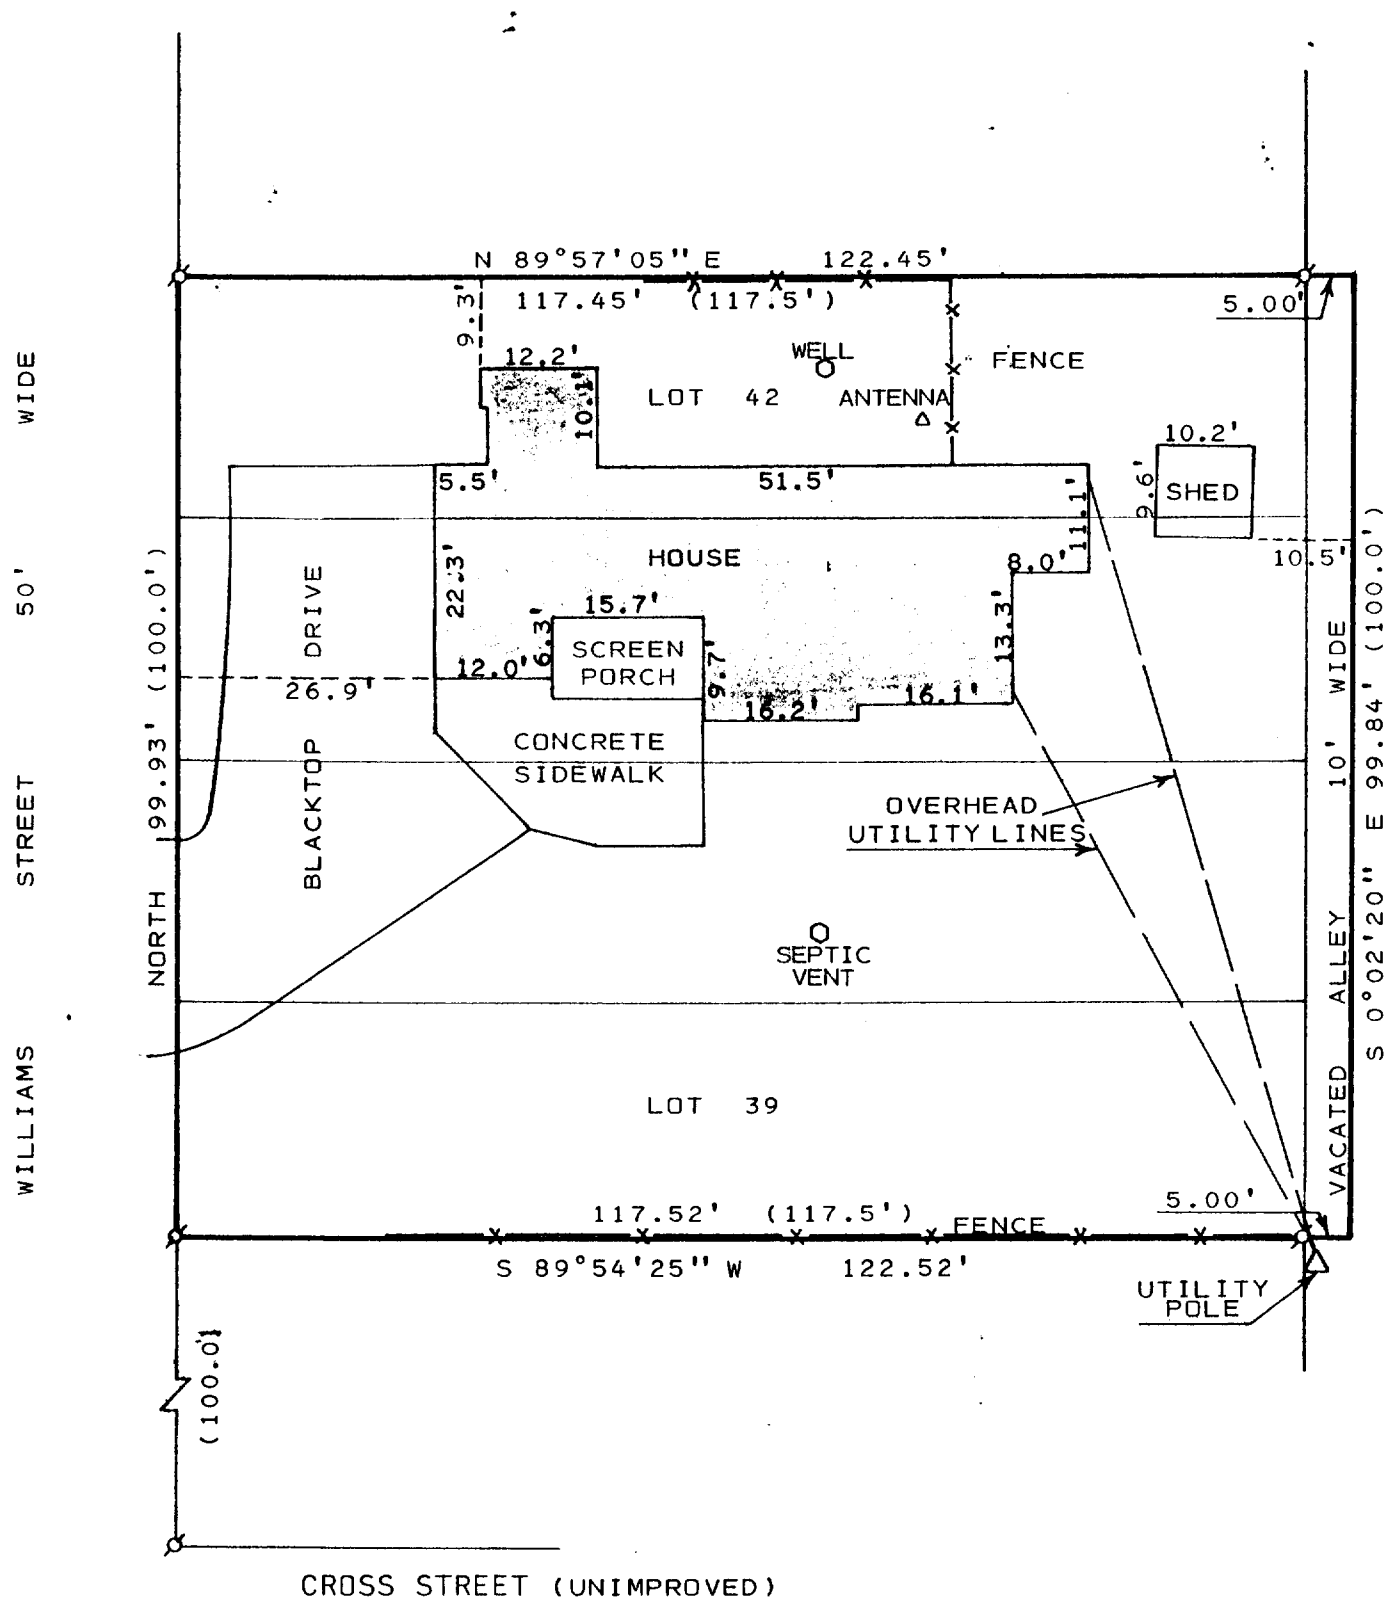


PLAT OF SURVEY OF

LOTS 39 THRU 42 OF GUMMOW ADDITION, A SUBDIVISION LOCATED IN THE NORTHWEST 1/4 OF SECTION 25, T2N, R17E, TOWN OF GENEVA, WALWORTH COUNTY, WISCONSIN.

ORDERED BY: FORBES GILES
ROUTE 5 BOX 1098
LAKE GENEVA, WI 53147

NOTE: THE EAST LINE OF WILLIAMS STREET IS ASSUMED NORTH.

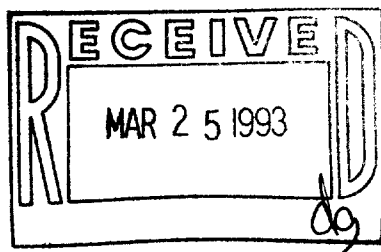

SCALE : 1" = 20'

LEGEND

⌀ - IRON PIPE FOUND
○ - IRON PIPE SET

I HEREBY CERTIFY THAT I HAVE SURVEYED THE ABOVE DESCRIBED PROPERTY AND THAT THE ABOVE MAP IS A TRUE REPRESENTATION THEREOF AND SHOWS THE SIZE AND LOCATION OF THE PROPERTY, ITS EXTERIOR BOUNDARIES, THE LOCATION OF ALL VISIBLE STRUCTURES AND DIMENSIONS OF ALL PRINCIPAL BUILDINGS THEREON, BOUNDARY FENCES, APPARENT EASEMENTS, ROADWAYS AND VISIBLE ENCROACHMENTS, IF ANY, TO THE BEST OF MY KNOWLEDGE AND BELIEF.

THIS SURVEY IS MADE FOR THE USE OF THE PRESENT OWNERS OF THE PROPERTY, AND ALSO THOSE WHO PURCHASE, MORTGAGE, OR GUARANTEE THE TITLE THERETO WITHIN ONE (1) YEAR FROM DATE HEREOF. THIS SURVEY IS NOT VALID UNLESS THE SURVEYOR'S SIGNATURE IS IN RED.

HAROLD H. KOLB
WISCONSIN REGISTERED LAND SURVEYOR, S-187
DATE _____

JGUM-11

217-1133