
ABELL SURVEYING & MAPPING DELAVAN. WISCONSIN 53115 414-728-6737



PLAT OF SURVEY OF

LOTS 10290 - 10301, BLOCK 187. LAKE COMO BEACH SUBDIVISION. LOCATED IN TON. RITE. WALWORTH COUNTY, WISCONSIN.



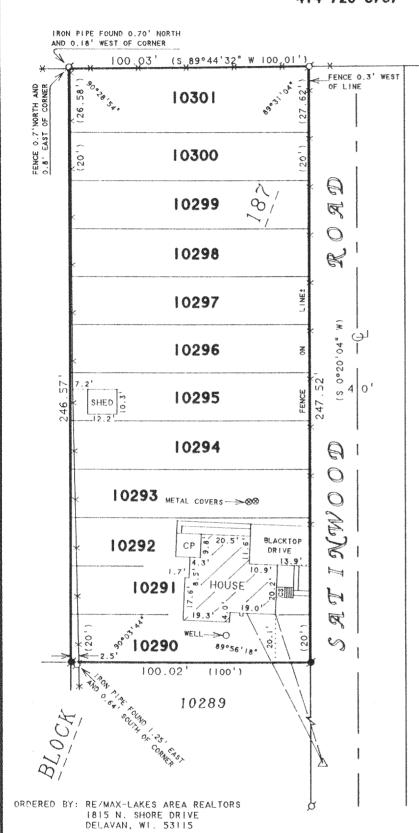

SCALE | "=40 '

LEGEND

Ø -IRON PIPE FOUND ■ -IRON ROD FOUND

→ -TRON ROD FOUND

→ -WIRE OR CHAINLINK FENCE

△ -UTILITY POLE

-OVERHEAD UTILITY LINES

CP -CONCRETE PATIO

CS -CONCRETE STOOP)-RECORDED AS

I HEREBY CERTIFY THAT I HAVE SURVEYED THE ABOVE DESCRIBED PROPERTY AND THAT THE ABOVE MAP IS A TRUE REPRESENTATION THEREOF AND SHOWS THE SIZE AND LOCATION OF THE PROPERTY. ITS EXTERIOR BOUNDARIES, THE LOCATION OF ALL VISIBLE STRUCTURES AND DIMENSIONS OF ALL PRINCIPAL BUILDINGS THEREON. BOUNDARY FENCES. APPARENT EASEMENTS. ROADWAYS AND VISIBLE ENCROACHMENTS. IF ANY, TO THE BEST OF MY KNOWLEDGE AND BELIEF.

THIS SURVEY IS MADE FOR THE USE OF THE PRESENT OWNERS OF THE PROFERTY, AND ALSO THOSE WHO PURCHASE, MORTGAGE, OR GUARANTEE THE TITLE THERETO WITHIN ONE (I) YEAR FROM PATE HEREON.

DAVID F. ABELL WISCONSIN REGISTERED LAND SURVEYOR, S-1596

August 11, 1993

DATE JOB NUMBER - 93174

NOTE: THIS IS NOT A CERTIFIED COPY UNLESS SEALED.

