


STATE TRUNK HIGHWAY 67

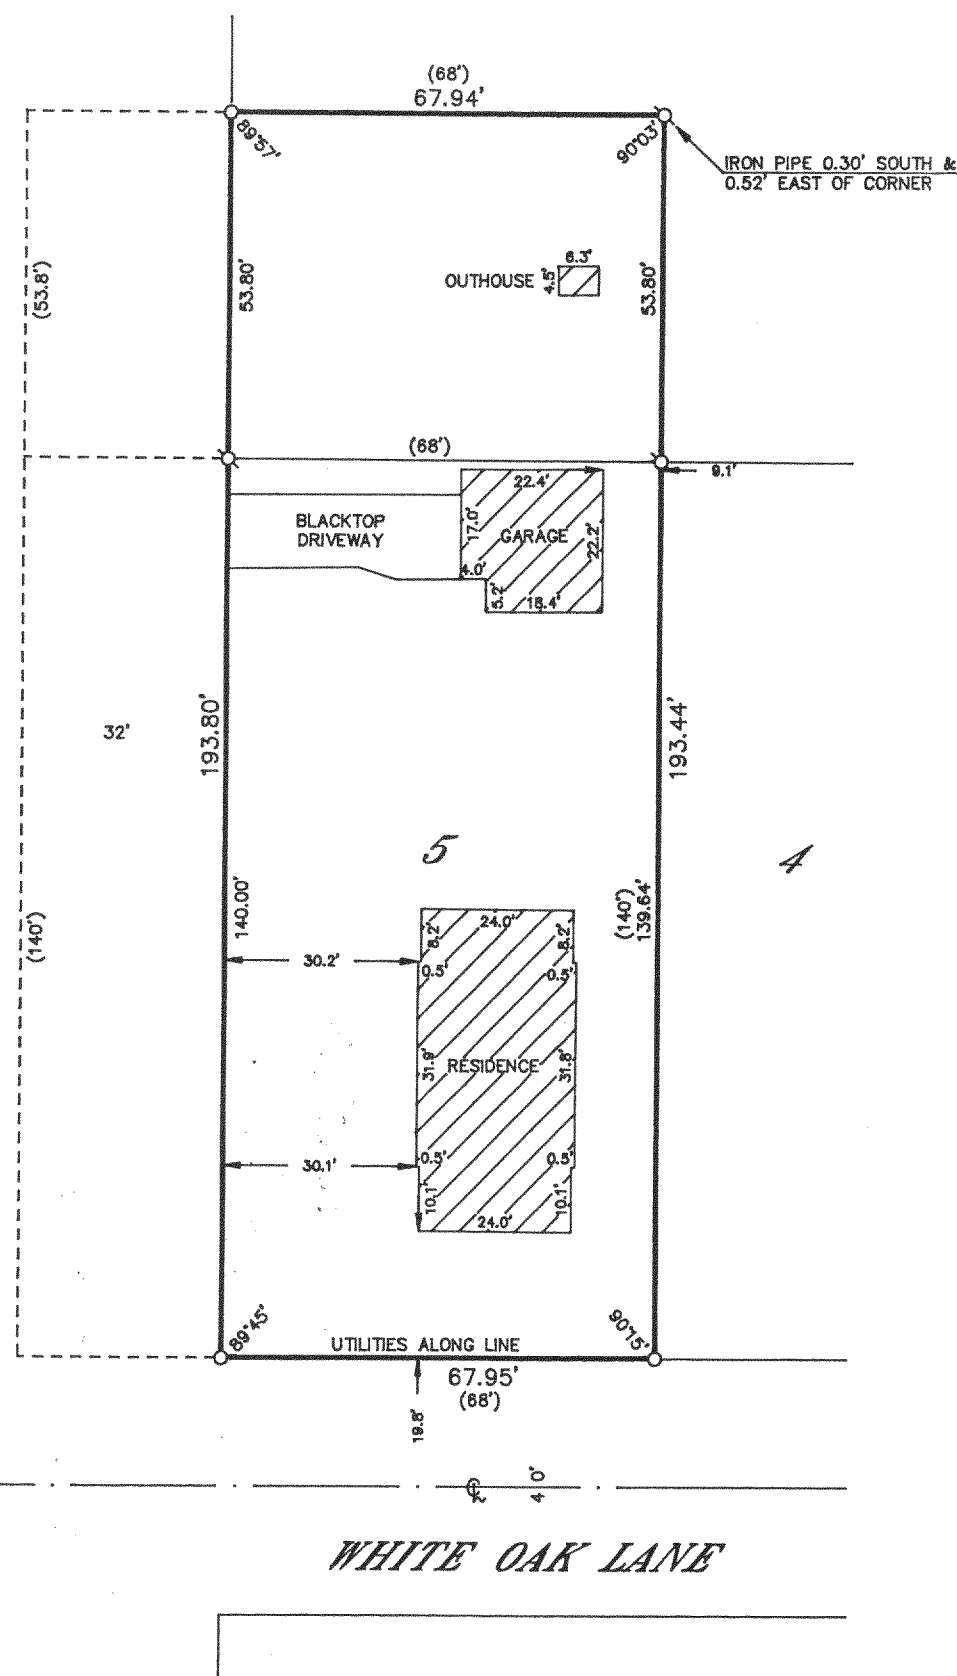

WALWORTH COUNTY
SURVEYING & MAPPING
727 HENRY STREET
LAKE GENEVA, WISCONSIN
414-248-0505

PLAT OF SURVEY OF

PLAT OF SURVEY OF LOT 5, BLOCK 1 OF FRANK A. JANUTKA LAKE VIEW SUBDIVISION, LOCATED IN SECTION 31, T 2 N, R 17 E, WALWORTH COUNTY, WISCONSIN. ALSO, PART OF OUTLOT 1 OF SAID SUBDIVISION, BEGINNING AT THE NORTHWEST CORNER OF SAID LOT 5, THENCE NORTH 53.8'; THENCE EAST 100 FEET; THENCE SOUTH 53.8 FEET; THENCE WEST 100 FEET TO THE PLACE OF BEGINNING, EXCEPTING THEREFROM LANDS DEEDED FOR HIGHWAY PURPOSES.

ORDERED BY: COLDWELL BANKER
GENEVA LAKES AREA REALTORS
838 MAIN STREET
LAKE GENEVA, WISCONSIN 53147


GRAPHIC SCALE



(IN FEET)

1 inch = 30 ft.

- Ø-IRON PIPE FOUND
- Ø-IRON ROD FOUND
- CONCRETE MONUMENT FOUND
- IRON PIPE PLACED
- ()-RECORDED AS

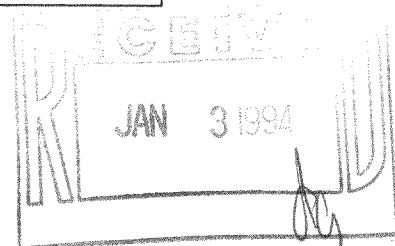

I HEREBY CERTIFY THAT I HAVE SURVEYED THE ABOVE DESCRIBED PROPERTY AND THAT THE ABOVE MAP IS A TRUE REPRESENTATION THEREOF AND SHOWS THE SIZE AND LOCATION OF THE PROPERTY, ITS EXTERIOR BOUNDARIES, THE LOCATION OF ALL VISIBLE STRUCTURES AND DIMENSIONS OF ALL PRINCIPAL BUILDINGS THEREON, BOUNDARY FENCES, APPARENT EASEMENTS, ROADWAYS AND VISIBLE ENCROACHMENTS, IF ANY, TO THE BEST OF MY KNOWLEDGE AND BELIEF.

THIS SURVEY IS MADE FOR THE USE OF THE PRESENT OWNERS OF THE PROPERTY AND ALSO THOSE WHO PURCHASE, MORTGAGE OR GUARANTEE THE TITLE THERETO WITHIN ONE (1) YEAR FROM DATE HEREOF.

Robert M. Baerenwald
ROBERT M. BAERENWALD
WISCONSIN REGISTERED LAND SURVEYOR, S-1508

DATE: 11/18/1993
JOB NO. 4059

NOTE: THIS IS NOT A CERTIFIED COPY UNLESS SEALED.