SCHOFIELD

NORTH

068

S A

Å

935.13

Wire

NORTHWEST

CORNER SEC. 34-2


PLAT OF SURVEY -OF-

LOT 1, CERTIFIED SURVEY MAP No. 169, being located in the Northwest 1/4 of Section 34, Township 2 North, Range 17 East in the Town of Geneva, Walworth County, Wisconsin.

Survey For: Valley Bank

Survey Location: N2826 Schofield Road


Buyers: Thomas & Ann Tenney

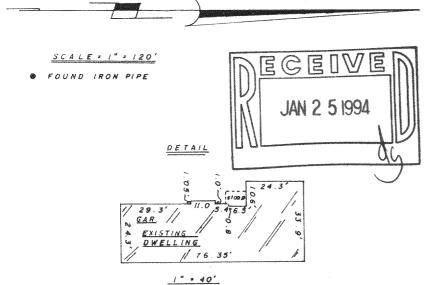



B.W. SURVEYING

Land Surveys
Mapping And Planning
35117 Academy Road
Burlington, Wisconsin 53105
(414) 534-4109

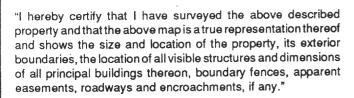

"This survey is made for the use of the present owners of the property, and those who purchase, mortgage, or guarantee the title thereto within one year from date hereof."



THIS IS NOT AN ORIGINAL PRINT UNLESS THIS SEAL IS RED

150.00' S 0° 04'15 W

Robert J. Wetzel

REGISTERED LAND SURVEYOR - 1778

10/29/93 DATE JOB NUMBER

JA 169-1

217-1219