
ABELL SURVEYING & MAPPING DELAVAN, WISCONSIN 53115

414-728-6737

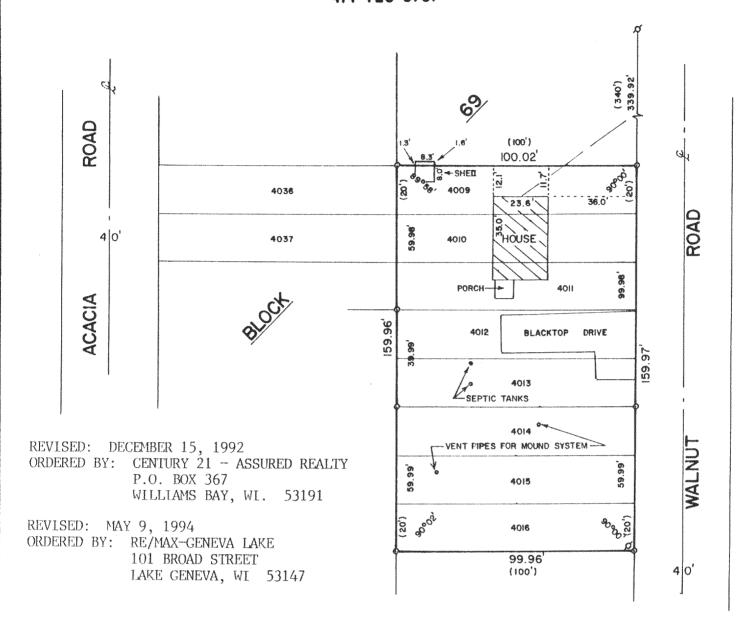

PLAT OF SURVEY OF


LOTS 4009-4016, BLOCK 69, LAKE COMO BEACH SUBDIVISION, T2N, R17E, WALWORTH COUNTY, WISCONSIN.

ORDERED BY: CE

CENTURY 21 - GENEVA LAKE

503 CENTER ST.

LAKE GENEVA, WI. 53147

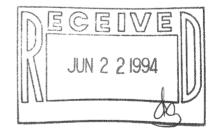



SCALE - 1"=40'

I HEREBY CERTIFY THAT I HAVE SURVEYED THE ABOVE DESCRIBED PROPERTY AND THAT THE ABOVE MAP IS A TRUE REPRESENTATION THEREOF AND SHOWS THE SIZE AND LOCATION OF THE PROPERTY. ITS EXTERIOR BOUNDARIES. THE LOCATION OF ALL VISIBLE STRUCTURES AND DIMENSIONS OF ALL PRINCIPAL BUILDINGS THEREON. BOUNDARY FENCES. APPARENT EASEMENTS. ROADWAYS AND VISIBLE ENCROACHMENTS. IF ANY. TO THE BEST OF MY KNOWLEDGE AND BELIEF:

THIS SURVEY IS MADE FOR THE USE OF THE PRESENT OWNERS OF THE PROPERTY. AND ALSO THOSE WHO PURCHASE, MORTGAGE, OR GUARANTEE THE TITLE THERETO WITHIN ONE (I) YEAR FROM DATE HEREON.

LEGEND

ø - IRON <u>PIPE</u> FOUND

• - IRON ROD SET, FOUND 12/15/92

()- RECORDED AS

- OVERHEAD UTILITY LINES

DAVID F. ABELL

WISCONSIN REGISTERED LAND SURVEYOR, S-1596

May 11, 1981

TE JOB NUMBER - 88030

NOTE: THIS IS NOT A CERTIFIED COPY UNLESS SEALED.