


45-40

OLD HIGHWAY 12

217-130B

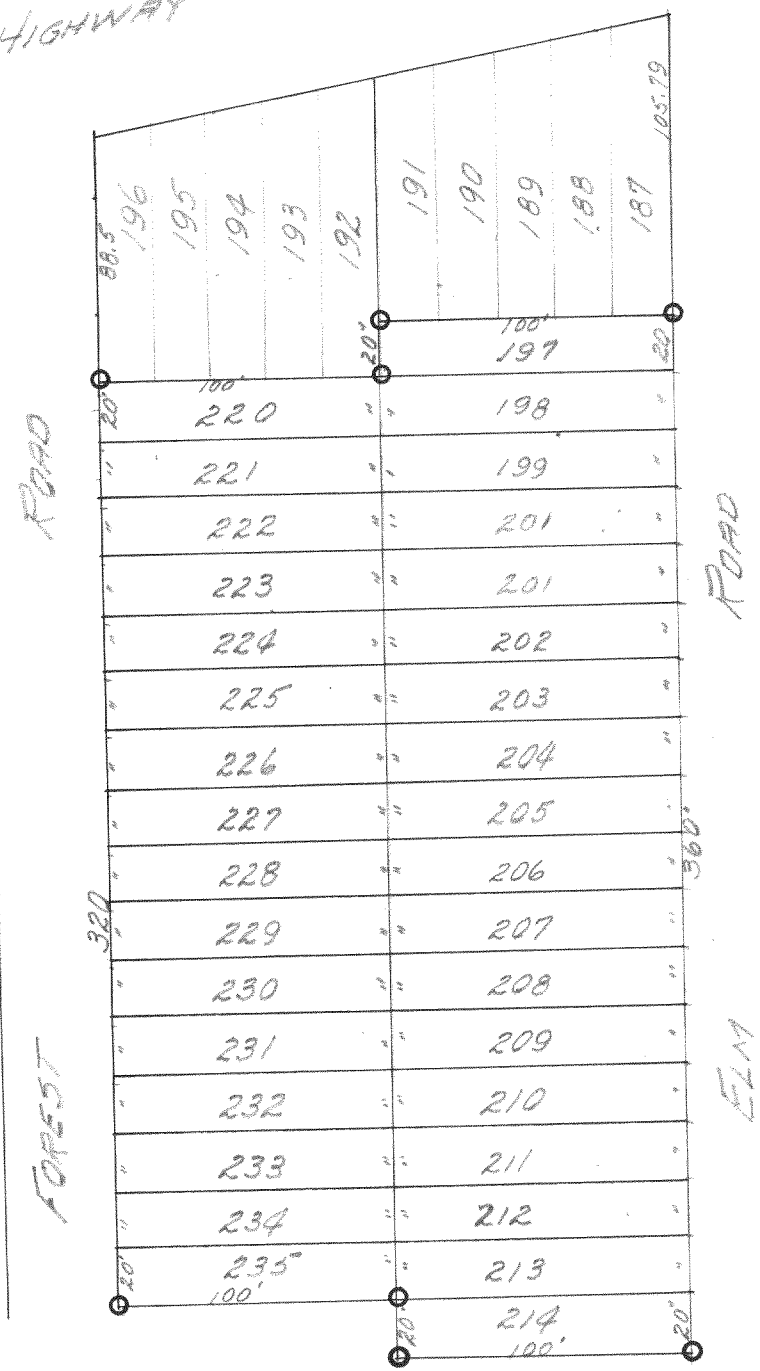

0-IRON STAKE

DESCRIPTION: Lots 197 to 214 inclusive and Lots 220 to 235 inclusive in Block 6, Lake Como Beach Subdivision of a portion of Sections 28, 22, and 29, Township 2 north, Range 17 east of the 4th P. M.

CERTIFICATE I, hereby certify that I have surveyed the above described property according to the official records on file in the Office of the Recorder of Deeds in and for Walworth County Wisconsin, and find that no encroachments exist.

SIGNED AND SEALED THIS 17TH DAY OF OCTOBER 1945.

JLCB- 31, 29A, 29B, 31B

Joseph M. Biagi
 Joseph M. Biagi.
 Professional Engineer
 Elkhorn Wisconsin.

217-130B