
KOLB LAND CONSULTING, INC.

LAND SURVEYING . SUBDIVIDING . LAND PLANNING


929 WILLIAMS STREET LAKE GENEVA, WISCONSIN 53147 4285

414 -248-3697

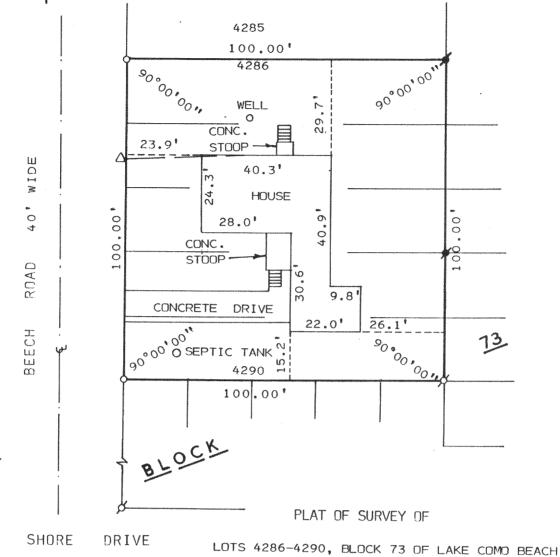

GENEVA, WALWORTH COUNTY, WISCONSIN. ORDERED BY: SUE GALLES 3303 WOODLAND CIRCLE N. IVAN LAKE, IL. 60042

LAKE

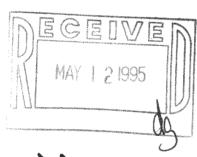



SCALE: 1" = 30' LEGEND

Ø - IRON PIPE FOUND

≠ - IRON ROD FOUND 0 - IRON PIPE SET

- OVERHEAD UTILITY LINE

△ - UTILITY POLE

I HEREBY CERTIFY THAT I HAVE SURVEYED THE ABOVE DESCRIBED PROPERTY AND THAT THE ABOVE MAP IS A TRUE REPRESENTATION THEREOF AND SHOWS THE SIZE AND LOCATION OF THE PROPERTY, ITS EXTERIOR BOUNDARIES, THE LOCATION OF ALL VISIBLE STRUCTURES AND DIMENSIONS OF ALL PRINCIPAL BUILDINGS THEREON, BOUNDARY FENCES, APPARENT EASEMENTS, ROADWAYS AND VISIBLE ENCROACHMENTS, IF ANY, TO THE BEST OF MY KNOWLEDGE AND BELIEF.

SUBDIVISION, LOCATED IN T2N, R17E, TOWN OF

THIS SURVEY IS MADE FOR THE USE OF THE PRESENT OWNERS OF THE PROPERTY AND ALSO THOSE WHO PURCHASE, MORTGAGE OR GUARANTEE THE TITLE THERETO WITHIN ONE (1) YEAR FROM DATE HEREOF.

SURVEY NOT VALID UNLESS SURVEYOR'S SIGNATURE IS IN RED.

HAROLD H. KOLB

| WISCONSIN | REGIST | ERED | LAND | SURVEYOR, | S | 187 |
|-----------|--------|------|------|-----------|---|-----|
| | | | | | | |

JANUARY 31, 1995 DATE.

REVISED_

REVISED_

2-17-JLCB-836