


(45-36)

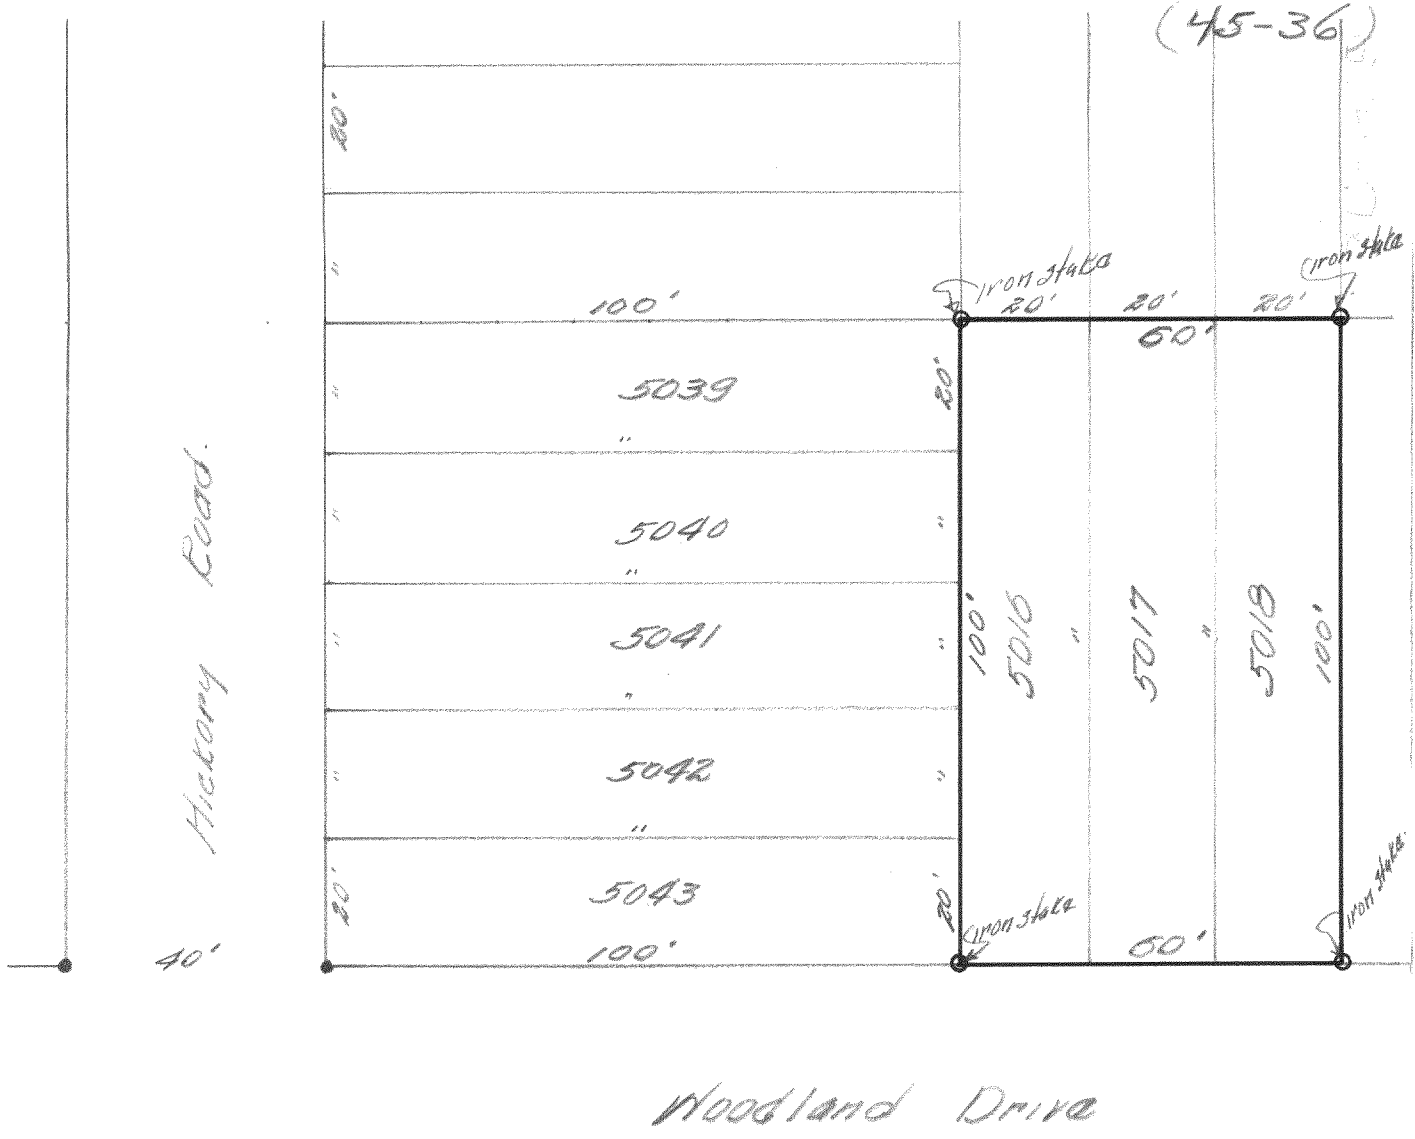

DESCRIPTION: Lots 5016, 5017 and 5018, Lake Como Beach Subdivision of a portion of Sections 28 and 29 Town 2 north, Range 17 east of the 4th P. M.

CERTIFICATE: I hereby certify that I have on this the 16th day of July 1945, surveyed the above described property according to official records on file in the office of the Recorder of Deeds in and for Walworth County, Wisconsin, and find that no encroachments exist, and that the plat hereon portrayed is an exact reproduction of the conditions found at the site on this day.

SIGNED AND SEALED THIS 17th DAY OF JULY 1945

Joseph M. Biagi
Joseph M. Biagi, Professional Eng.
Elkhorn Wisconsin. 217-147B