


1140 SEQUOIA STREET • DELAVAN, WISCONSIN 53115
414-728-6737

1140 SEQUOIA STREET • DELAVAN, WISCONSIN 53115
414-728-6737

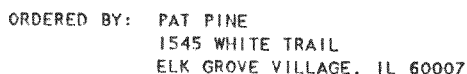

LOTS 4046-4050, BLOCK 69, LAKE COMO BEACH
SUBDIVISION, LOCATED IN T2N, R17E, WALWORTH
COUNTY, WISCONSIN.

I HEREBY CERTIFY THAT I HAVE SURVEYED THE ABOVE DESCRIBED PROPERTY AND THAT THE ABOVE MAP IS A TRUE REPRESENTATION THEREOF AND SHOWS THE SIZE AND LOCATION OF THE PROPERTY, ITS EXTERIOR BOUNDARIES, THE LOCATION OF ALL VISIBLE STRUCTURES AND DIMENSIONS OF ALL PRINCIPAL BUILDINGS THEREON, BOUNDARY FENCES, APPARENT EASEMENTS, ROADWAYS AND VISIBLE ENCROACHMENTS, IF ANY, TO THE BEST OF MY KNOWLEDGE AND BELIEF.

THIS SURVEY IS MADE FOR THE USE OF THE PRESENT OWNERS OF THE PROPERTY, AND ALSO THOSE WHO PURCHASE, MORTGAGE, OR GUARANTEE THE TITLE THERETO WITHIN ONE (1) YEAR FROM DATE HEREON.

DAVID F. ABELL
WISCONSIN REGISTERED LAND SURVEYOR, S-1596

August 12, 1997

DATE _____ JOB NUMBER - 97148
NOTE: THIS IS NOT A CERTIFIED COPY UNLESS SEALED.

SCALE 1" = 20'

LEGEND

- O - IRON PIPE FOUND
 IR - IRON ROD FOUND
 PS - PLASTIC STOOP
 XX - XX - CHAINLINK FENCE
 ———— - OVERHEAD UTILITY LINES
 () - RECORDED AS

RECEIVED
JUN 11 1997
dc

JLCB-776

217-1480