

#14-66


LONGFELLOW

ROAD


ROAD

QUAIL

● Iron Stake

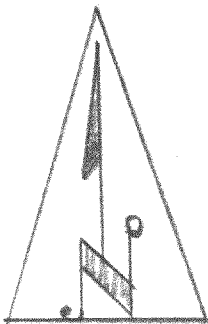


NORTH

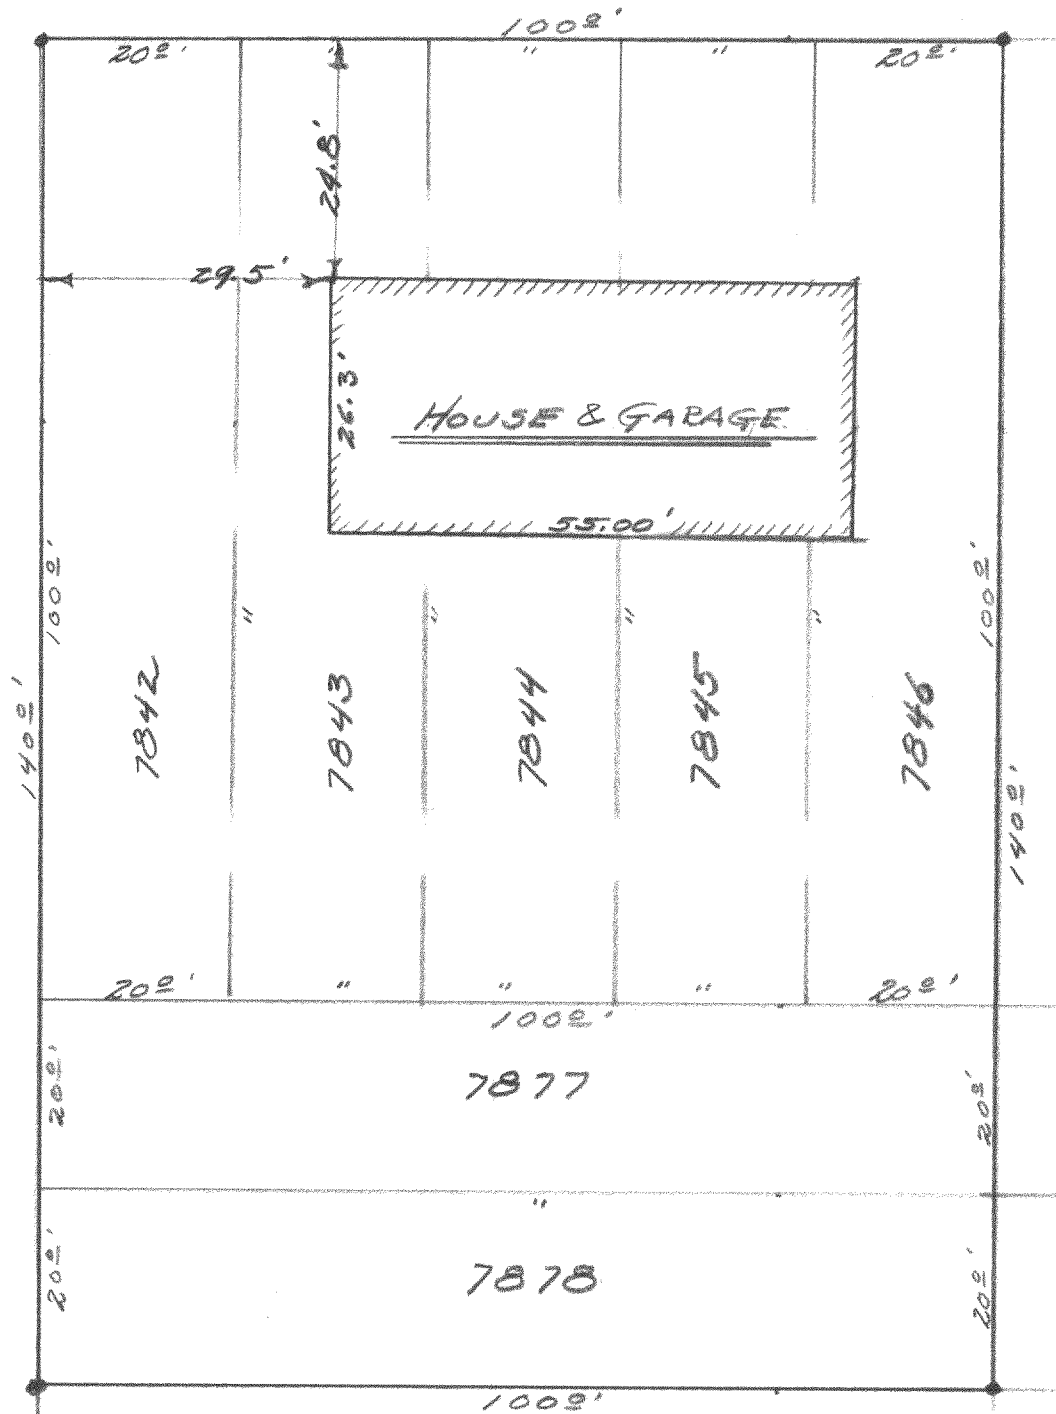

DESCRIPTION: Lots 7842 to 7846 inclusive and Lots 7877 and 7878 in Lake Como Beach Subdivision according to the recorded plat thereof. Said land being in the Township of Geneva, Walworth County, Wisconsin.

CERTIFICATE: I hereby certify that I have surveyed the above mentioned property and that the hereon portrayed is an accurate survey and a true representation thereof and correctly shows the exterior boundary lines and the location of the buildings and other improvements thereof.

Dated February 4th 1966.

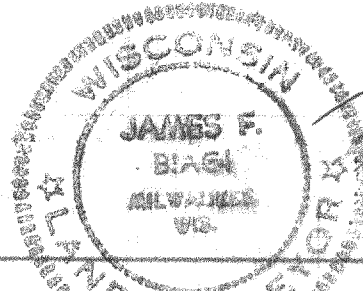

James F. Biagi, SLS 272
Elkhorn, Wisconsin.

JLCB-11669

217-159B