


PLAT OF SURVEY

PATHFINDER SURVEYING
FORMERLY KOLB LAND CONSULTING
828 WILLIAMS ST. LAKE GENEVA, WI.
(414) 248-3697

ORDERED BY : FLORENCE NETZEL
514 FREE CHURCH DRIVE WILLIAMS BAY WISCONSIN 53191



DATE: 7/7/1998

DESCRIPTION: OUT-LOT 1 CERTIFIED SURVEY MAP NUMBER 368 LOCATED IN THE NORTHWEST 1/4 OF
SECTION 35, T 2 N, R 17 E, WALWORTH COUNTY, WISCONSIN

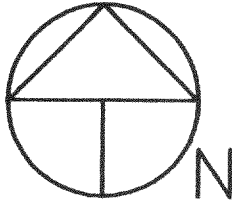

SCALE 1"=100'

BEARINGS REFERENCED TO C.S.M# 368

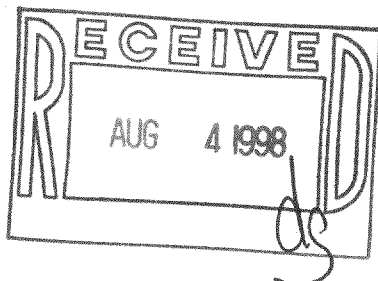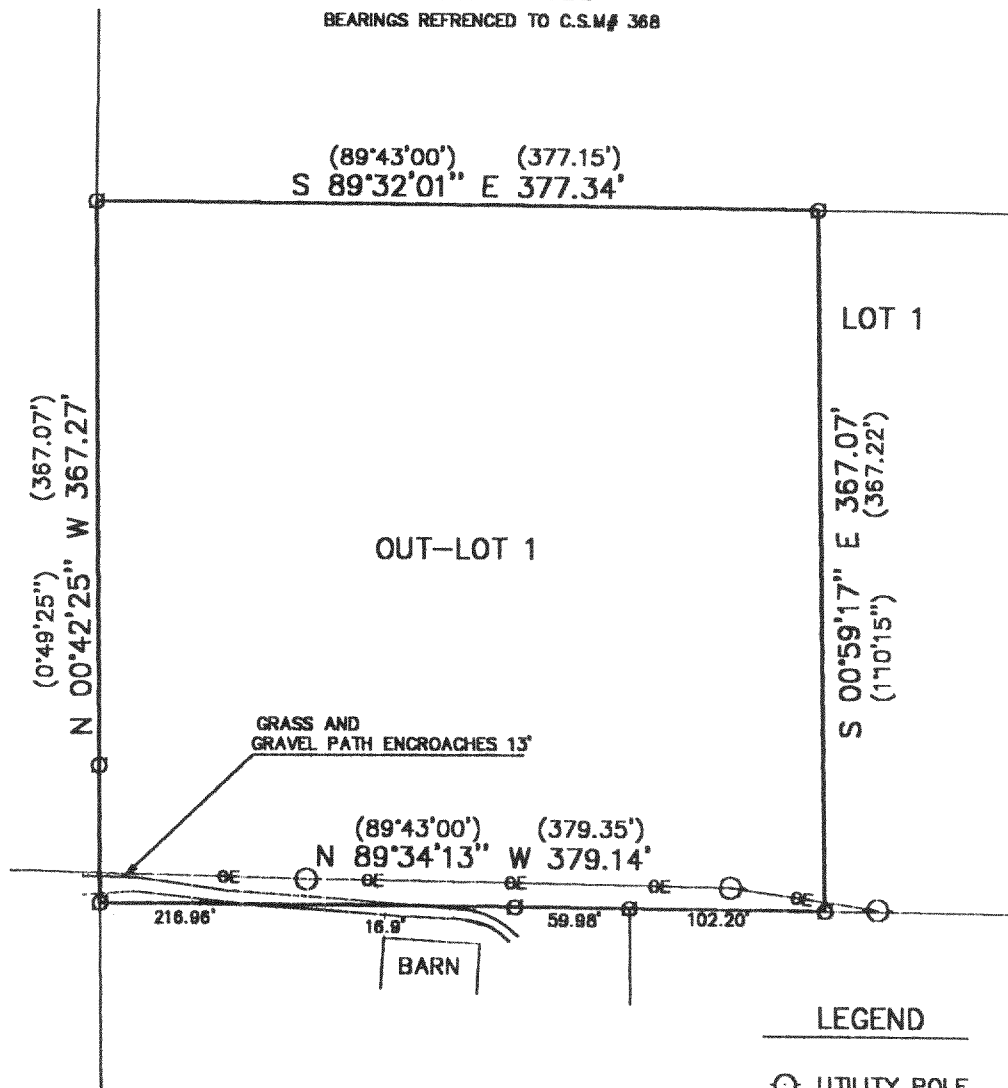

THE ABOVE MAP IS A TRUE REPRESENTATION THEREOF AND SHOWS THE SIZE AND LOCATION OF ALL THE PROPERTY, EXTERIOR BOUNDARIES, THE LOCATION OF ALL VISIBLE BOUNDARY FENCES, APPARENT EASEMENTS, ROADWAYS AND VISIBLE ENCROACHMENTS, IF ANY.

THIS SURVEY IS MADE FOR THE USE OF THE PRESENT OWNERS OF THE PROPERTY, AND ALSO THOSE WHO PURCHASE, MORTGAGE OR GURANTEE TITLE THERETO WITHIN ONE (1) YEAR FROM DATE HERETO.

John P. Krott
JOHN P. KROTT, R.L.S. 2258



NOTE: THIS IS NOT A CERTIFIED COPY
UNLESS SEAL IS IN RED.
JOB NUMBER 98071 2-17-JA36800002

JA-368-2

217-1644