


FARRIS, HANSEN & ASSOC. INC.

7 RIDGWAY COURT- P.O. BOX 437
ELKHORN, WISCONSIN 53121
PHONE (414) 723-2098
FAX (414) 723-5886

PLAT OF SURVEY OF LOTS 6173-6182
OF LAKE COMO BEACH SUBDIVISION
IN SEC 28-2-17 WALWORTH CO. WI.
TAX PARCEL # JLCB 1275

WORK ORDERED BY: LISA DROHNER
W 974 CLAYTON COURT
BURLINGTON, WI. 53105

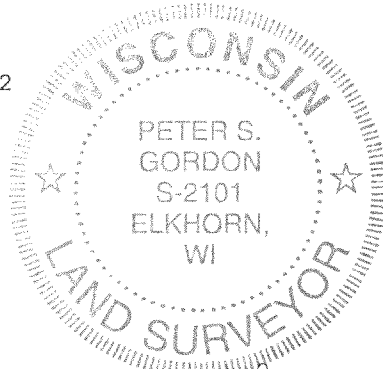

NOTE: COPIES OF THIS MAP TO WHICH THE FOLLOWING CERTIFICATE
WILL APPLY SHOW THE SURVEYOR'S ORIGINAL SEAL AND SIGNATURE
IN RED INK. COPIES BY ANY OTHER MEANS MAY HAVE ALTERATIONS
WHICH DO NOT REPRESENT THE SURVEYOR'S WORK PRODUCT.


I HEREBY CERTIFY THAT THE ABOVE DESCRIBED PROPERTY HAS BEEN
SURVEYED UNDER MY DIRECTION AND THAT THE ABOVE MAP IS A TRUE
REPRESENTATION THEREOF AND SHOWS THE SIZE AND LOCATION OF
THE PROPERTY AND ITS EXTERIOR BOUNDARIES. THIS SURVEY IS
MADE FOR THE USE OF THE PRESENT OWNERS OF THE PROPERTY, AND
ALSO THOSE WHO PURCHASE, MORTGAGE, OR GUARANTEE THE TITLE
THERE TO WITHIN ONE YEAR FROM THE DATE HEREOF.

DATED: 10/27/98

Peter S. Gordon
PETER S. GORDON R.L.S. 2101



MAP SCALE IN FEET ORIGINAL 1" = 30'

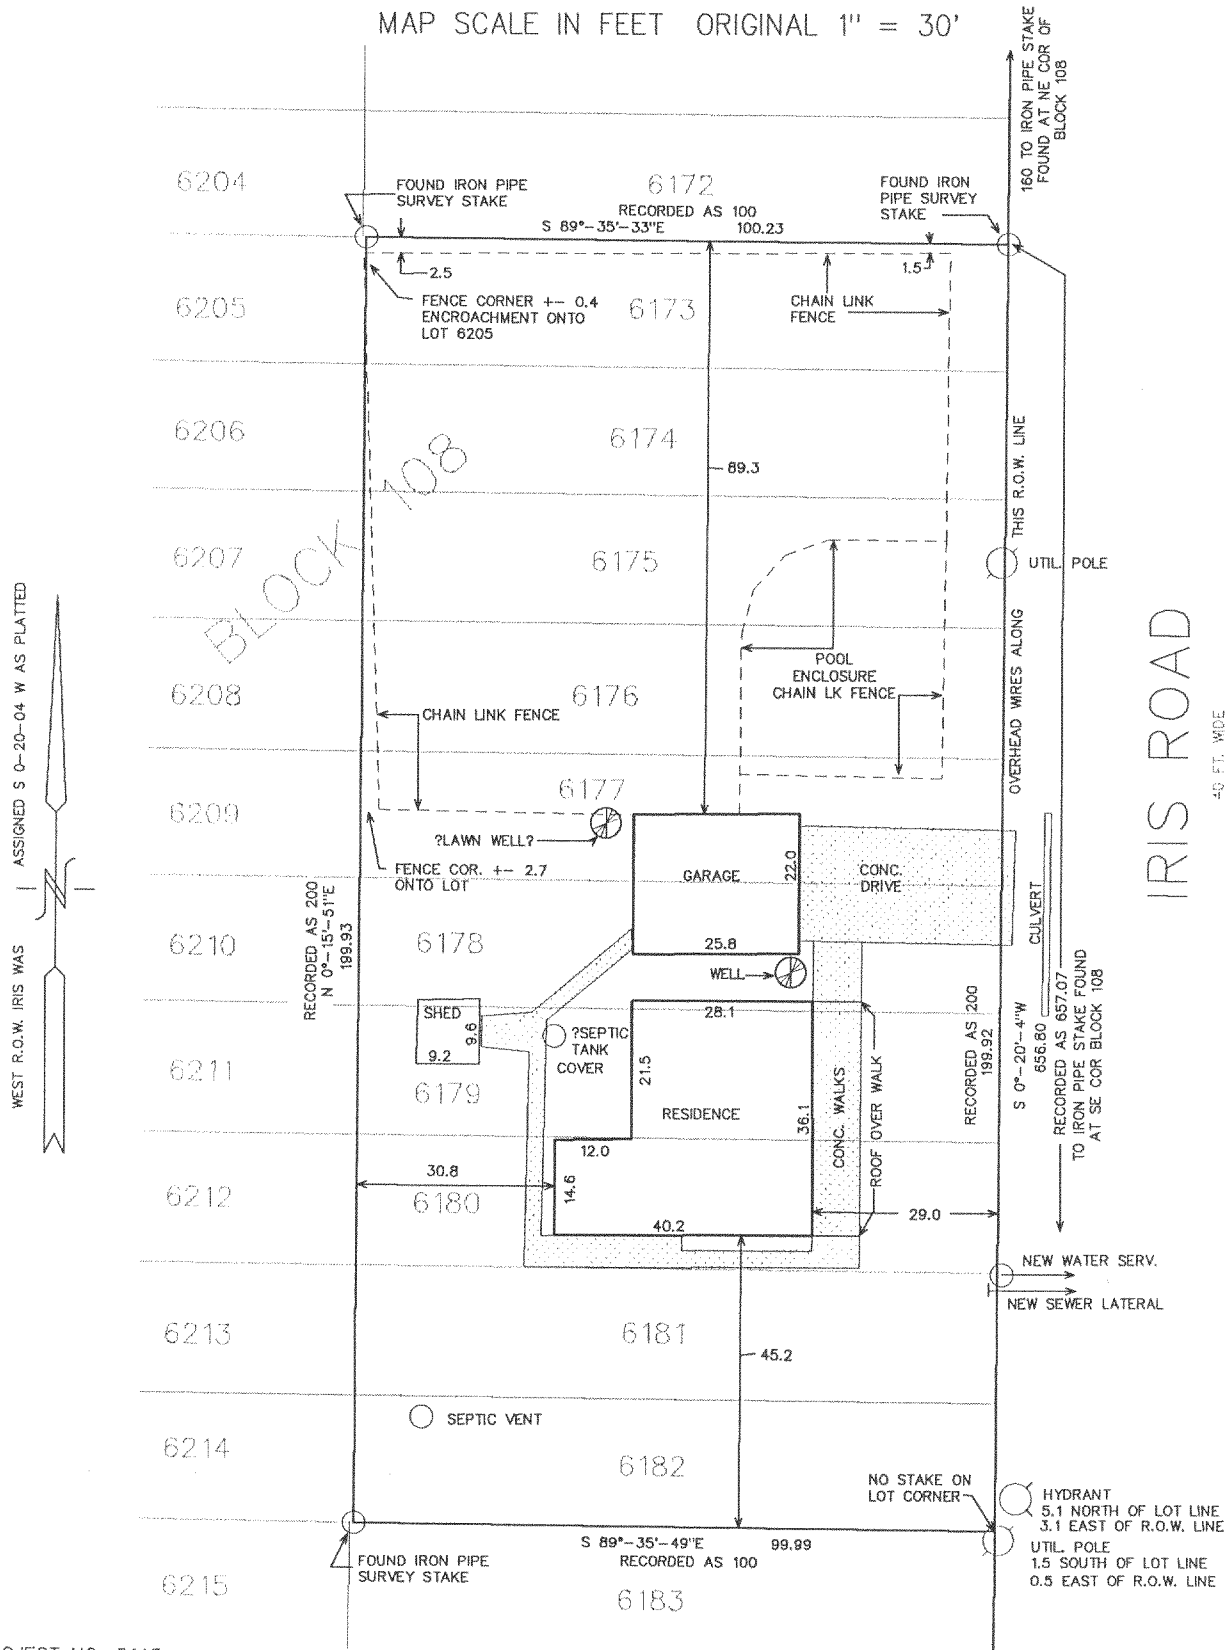

PROJECT NO. 5143
SHEET 1 OF 1 SHEETS

TYPICAL LOT SHOWN ON ORIGINAL PLAT 20 X 100
AREA OF THE TEN LOTS SURVEYED AS A GROUP = 20,014 SF

OCT 27 1998
JLCB-1275 217-1683