



PLAT OF SURVEY

LOCATION: 10222-10231 Satinwood Road, Geneva, Wisconsin

LEGAL DESCRIPTION: Lots 10222 to 10231, inclusive, in Block 186, designated and delineated on the map entitled "Fifth Map of Lake Como Beach, Walworth County, Wisconsin" located in Section 28, Town 2 North, Range 17 East, Town of Geneva, Walworth County, Wisconsin.

March 16, 1999

Survey No. 90852

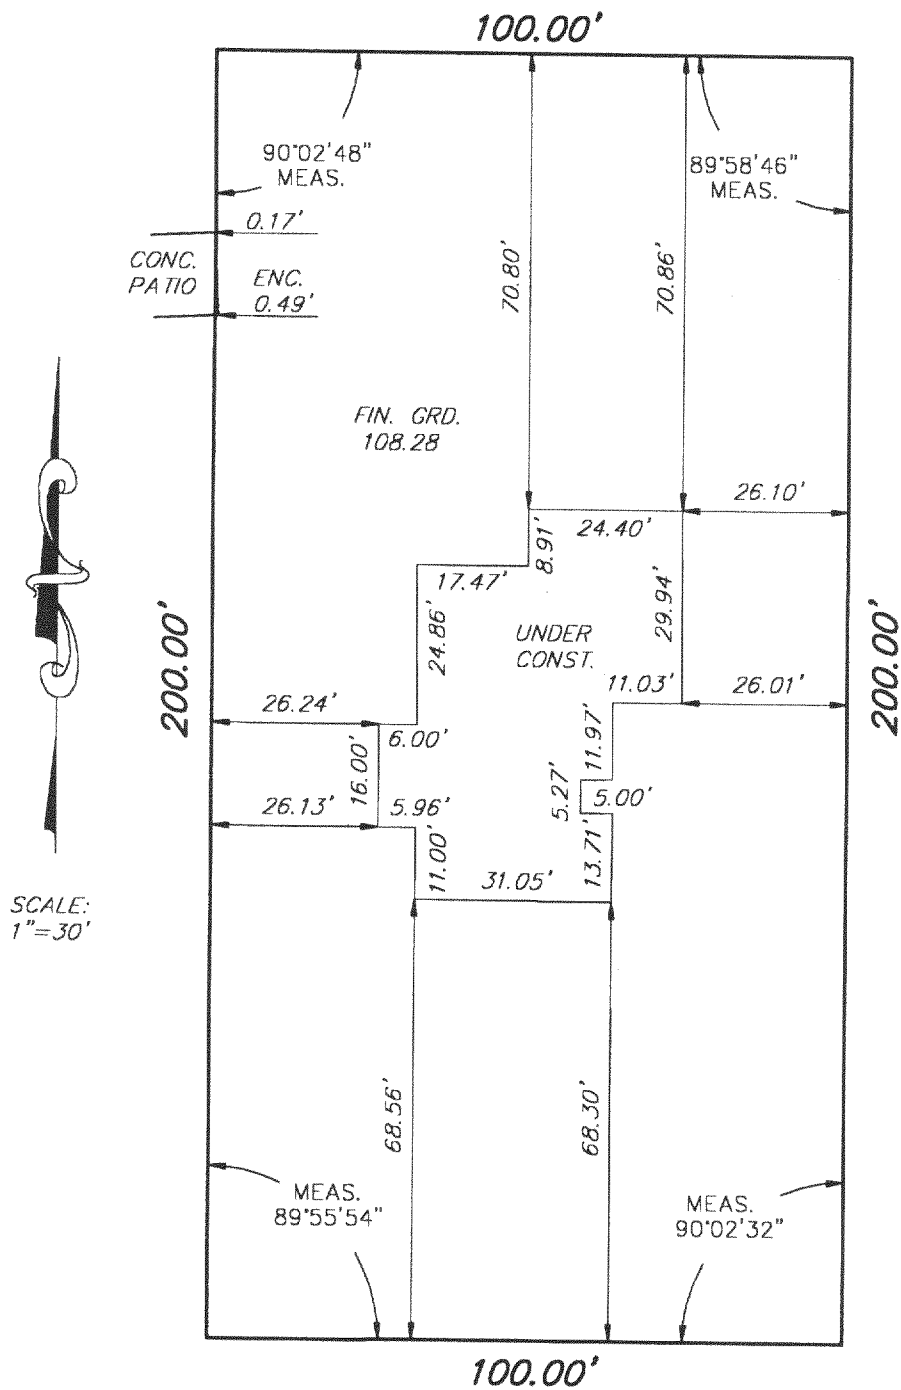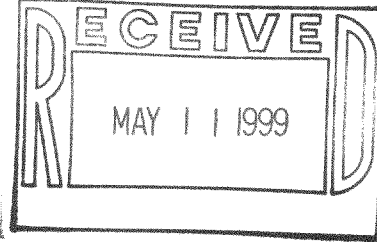

SCALE:
1"=30'



METROPOLITAN SURVEY SERVICE, INC.

REGISTERED LAND SURVEYORS

415 W. FOREST HOME AVE., SUITE 202, HALES CORNERS, WI 53130

PH. 529-5380 FAX 529-9787

I HEREBY CERTIFY THAT I HAVE SURVEYED THE ABOVE DESCRIBED PROPERTY AND THAT THE ABOVE MAP IS A TRUE REPRESENTATION THEREOF AND SHOWS THE SIZE AND LOCATION OF THE PROPERTY, ITS EXTERIOR BOUNDARIES, THE LOCATION OF ALL VISIBLE STRUCTURES AND DIMENSIONS OF ALL PRINCIPAL BUILDINGS THEREON, BOUNDARY FENCES, APPARENT EASEMENTS AND ROADWAYS AND VISIBLE ENCROACHMENTS, IF ANY.

THIS SURVEY IS MADE FOR THE EXCLUSIVE USE OF THE PRESENT OWNERS OF THE PROPERTY, AND ALSO THOSE WHO PURCHASE, MORTGAGE, OR GUARANTEE THE TITLE THERETO WITHIN ONE (1) YEAR FROM DATE HEREOF.

SIGNED

Gerald E. Casey
Registered Land Surveyor S-1329

217-1727

JLCB-2211