
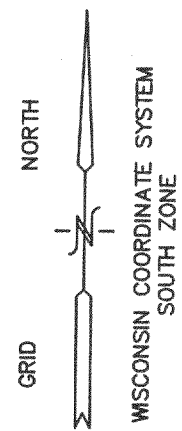


# PLAT OF SURVEY

UNIT 15-22  
GENEVA NATIONAL CONDOMINIUM  
NO. 15  
LOCATED IN TOWN 2 NORTH, RANGE 17 EAST  
WALWORTH COUNTY, WISCONSIN

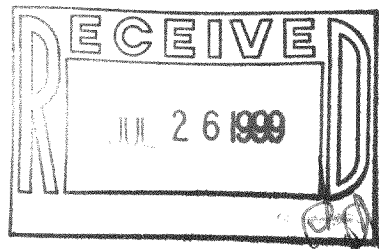

⊗ = FOUND IRON REBAR STAKE  
XXX = PROPOSED FINISH ELEVATION

CARNOUSTIE CT  
66' WIDE PRIVATE ROADWAY

MH #NO REC

R=192.00  
A=135.18  
C=133.34  
N 35° 01' 02" E

S 59° 43' 59" E  
149.91

G.E. = 1058.4

AS BUILT FOUNDATION  
T.O.F. = 1067.5

G.E. = 1064.93

RAD = 334.80' ARC = 153.81'  
CHD = 152.46' N 67° 46' 29" W

UNIT 15-22  
18,446 S.F.

UTIL BOXES

N 35° 23' 10" E  
112.00

GENEVA NATL. AVE  
66' WIDE PRIVATE ROADWAY

UTIL BOXES

MH #3-48



MH #3-49

NOTE: COPIES OF THIS MAP TO WHICH THE FOLLOWING CERTIFICATE WILL APPLY SHOW SURVEYOR'S ORIGINAL SEAL AND SIGNATURE IN RED INK. COPIES BY ANY OTHER MEANS MAY HAVE ALTERATIONS WHICH DO NOT REPRESENT THE SURVEYOR'S WORK PRODUCT.

I HEREBY CERTIFY THAT THE ABOVE DESCRIBED PROPERTY HAS BEEN SURVEYED UNDER MY DIRECTION AND THAT THE ABOVE MAP IS A TRUE REPRESENTATION THEREOF AND SHOWS THE SIZE AND LOCATION OF THE PROPERTY AND ITS EXTERIOR BOUNDARIES. THIS SURVEY IS MADE FOR THE USE OF THE PRESENT OWNERS OF THE PROPERTY, AND ALSO THOSE WHO PURCHASE, MORTGAGE, OR GUARANTEE THE TITLE THERETO WITHIN ONE YEAR FROM THE DATE HEREOF.

DATED: 6-24-99

PETER S. GORDON R.L.S. 2101

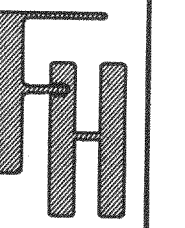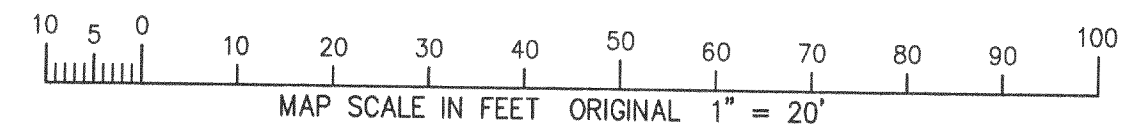

UNIT 15-22  
GENEVA NATIONAL CONDOMINIUM  
WALWORTH CO., WI.

ORDERED BY: MARINO CECCHI  
7 LISA LANE  
HAWTHORNE WOODS, IL. 60047

FARRIS, HANSEN & ASSOCIATES, INC.  
Engineering, Architecture, Surveying  
7 Ridgway Court P.O. Box 437  
ELKHORN, WISCONSIN 53121  
Office: (414) 723-2098  
Fax: (414) 723-5886

REVISIONS  
04-05-99  
SHOW FRONT  
DECK W/REV.  
LOCATION

06-24-99  
TO SHOW  
ASBUILT  
FOUNDATION

PROJECT NO.  
3269.1522.98

DATE:  
09/03/98

SHEET NO.  
1 OF 1

JGN-15-22

217-1751