

PLAT OF SURVEY


PATHFINDER SURVEYING
FORMERLY KOLB LAND CONSULTING
929 WILLIAMS STREET LAKE GENEVA, WI. 53147
(414) 248-3697

ORDERED BY: MARAGARET DEMBSKI
N 3388 DELL PLACE
LAKE GENEVA, WI 53147


DATE: 7-7-1999

DESCRIPTION: LOTS 9498 THRU 9502 BLOCK 171
LAKE COMO BEACH SUBDIVISION
A SUBDIVISION LOCATED IN SECTION
21, T2N, 217E, WALWORTH COUNTY
WISCONSIN.

SCALE 1"=20'
BEARINGS REFERENCED TO THE RECORD
PLAT OF LAKE COMO BEACH SUBDIVISION

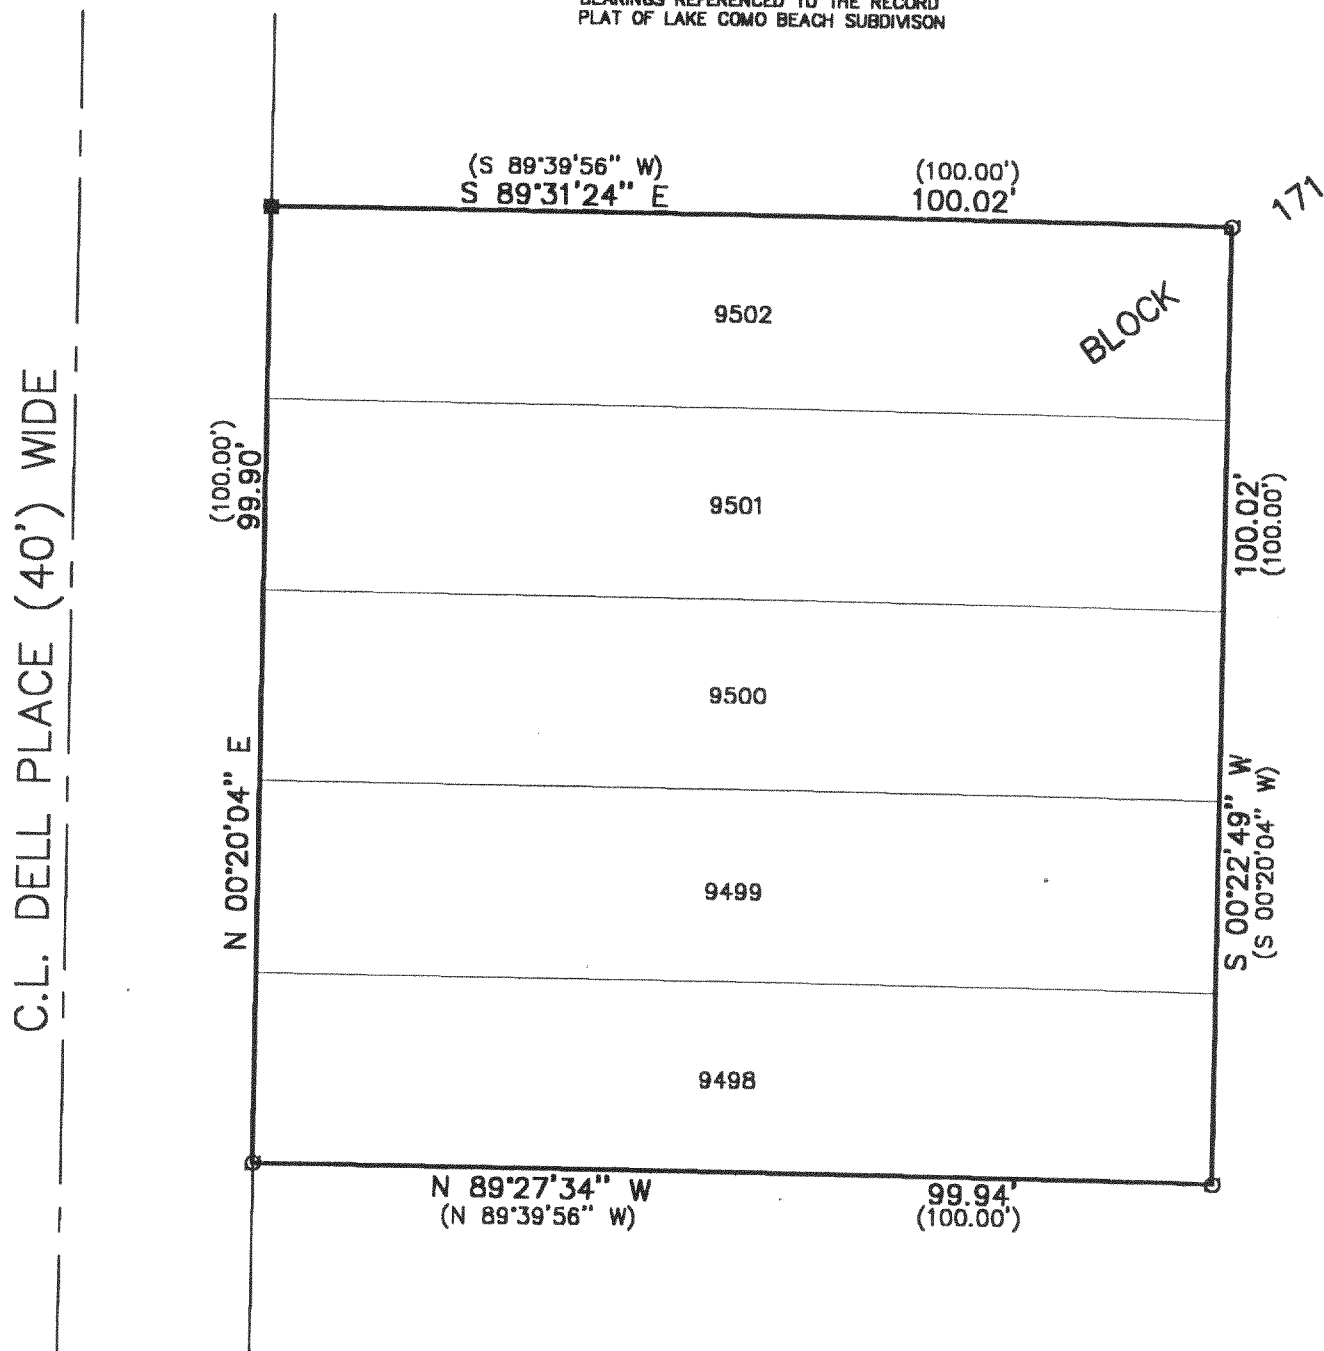


LEGEND
○ FOUND IRON PIPE
■ FOUND IRON PIN
(XXX) RECORDED AS

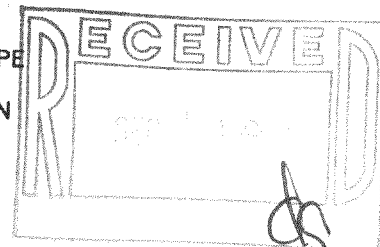

THE ABOVE MAP IS A TRUE REPRESENTATION THEREOF AND
SHOWS THE SIZE AND LOCATION OF ALL THE PROPERTY,
EXTERIOR BOUNDARIES, THE LOCATION OF ALL VISIBLE
BOUNDARY FENCES, APPARENT EASEMENTS, ROADWAYS
AND VISIBLE ENCROACHMENTS, IF ANY

THIS SURVEY IS MADE FOR THE USE OF THE PRESENT
OWNERS OF THE PROPERTY, AND ALSO THOSE WHO
PURCHASE, MORTGAGE OR GUARANTEE TITLE THERETO
WITHIN ONE (1) YEAR FROM DATE HERETO.

JOHN P. KROTT, R.L.S. 2258

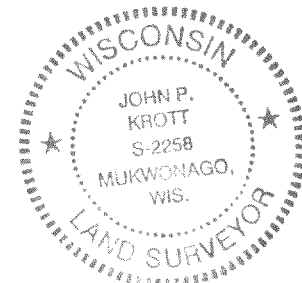

NOTE: THIS IS NOT A CERTIFIED COPY
UNLESS SEAL IS IN RED.
JOB NUMBER #99136 2-17-JLCB 2048

217-1798

JLCB-2048