PATHFINDER SURVEYING


FORMERLY KOLB LAND CONSULTING 929 WILLIAMS STREET LAKE GENEVA, WI. 53147 (414) 248-3697


ORDERED BY: JEAN WALKER

4756 W. BRYNMAWR CHICAGO, IL. 60646

DESCRIPTION:

LOTS 20 THRU 22, BLOCK 16A OF SUNSET HILLS, A SUBDIVISON LOCATED IN SECTION 33, T2N, R17E, WALWORTH COUNTY, WISCONSIN. DATE: 7-23-1999

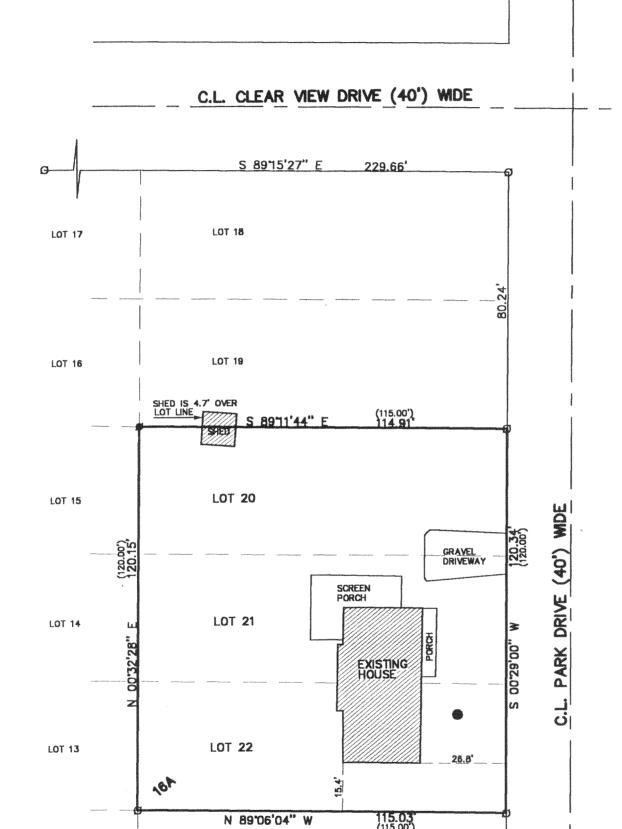

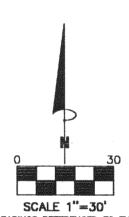

BEARINGS REFERENCED TO THE RECORD PLAT OF SUNSET HILLS

THE ABOVE MAP IS A TRUE REPRESENTATION THEREOF AND SHOWS THE SIZE AND LOCATION OF ALL THE PROPERTY. EXTERIOR BOUNDARIES, THE LOCATION OF ALL VISIBLE BOUNDARY FENCES, APPARENT EASEMENTS, ROADWAYS AND VISIBLE ENCROACHMENTS, IF ANY

LOT 23

THIS SURVEY IS MADE FOR THE USE OF THE PRESENT OWNERS OF THE PROPERTY , AND ALSO THOSE WHO PURCHASE , MORTGAGE OR GURANTEE TITLE THERETO WITHIN ONE (1) YEAR FROM DATE HERETO.

LEGEND

0 FOUND IRON PIPE

SET IRON PIPE

(XXXX) RECORDED AS

WELL



WEGEIMEW

SEP 1 4 1999

NOTE: THIS IS NOT A CERTIFIED COPY UNLESS SEAL IS IN RED. JOB NUMBER #99146 JSH 00061

JOHN P. KROTT , R.L.S. 2258