


59-68

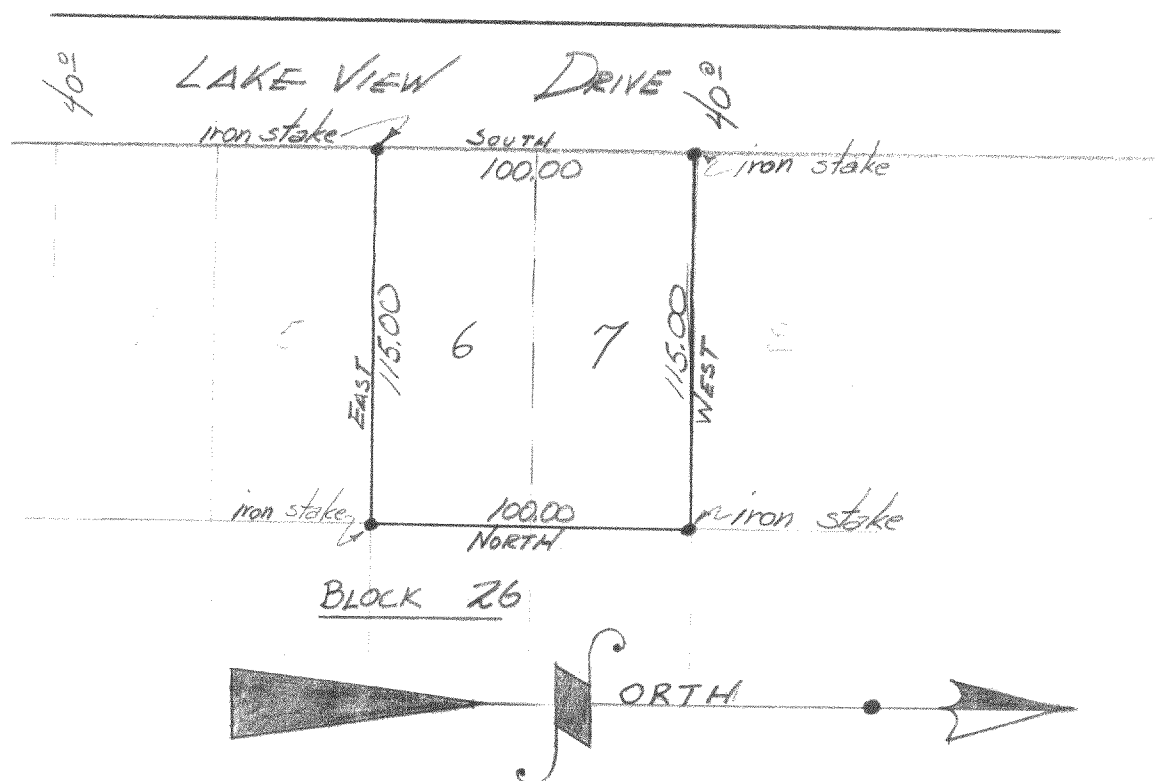


BLOCK 26

2091-578

DESCRIPTION: Lots 6 and 7 of Block 26 of Sunset Hills Subdivision, a subdivision of part of the South $\frac{1}{2}$ of Section 33 Town 2 North, Range 17 East of the 4th Principal Meridian, in Walworth County, Wisconsin.

Certificate: I, James F. Biagi, surveyor, do hereby certify that I have surveyed the above described property, and that said survey is in accordance with the official records on file in the Register of Deeds office, Walworth County, Wisconsin.

SIGNED AND SEALED 23 MARCH 1959

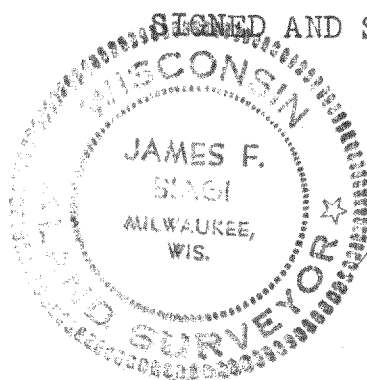

James F. Biagi
Surveyor (272)

217-180B