
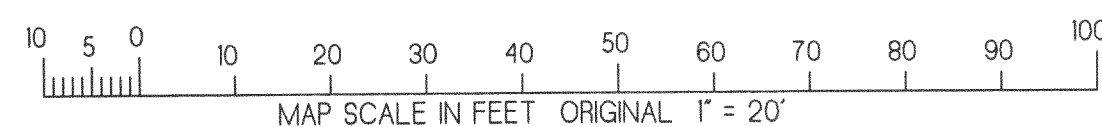
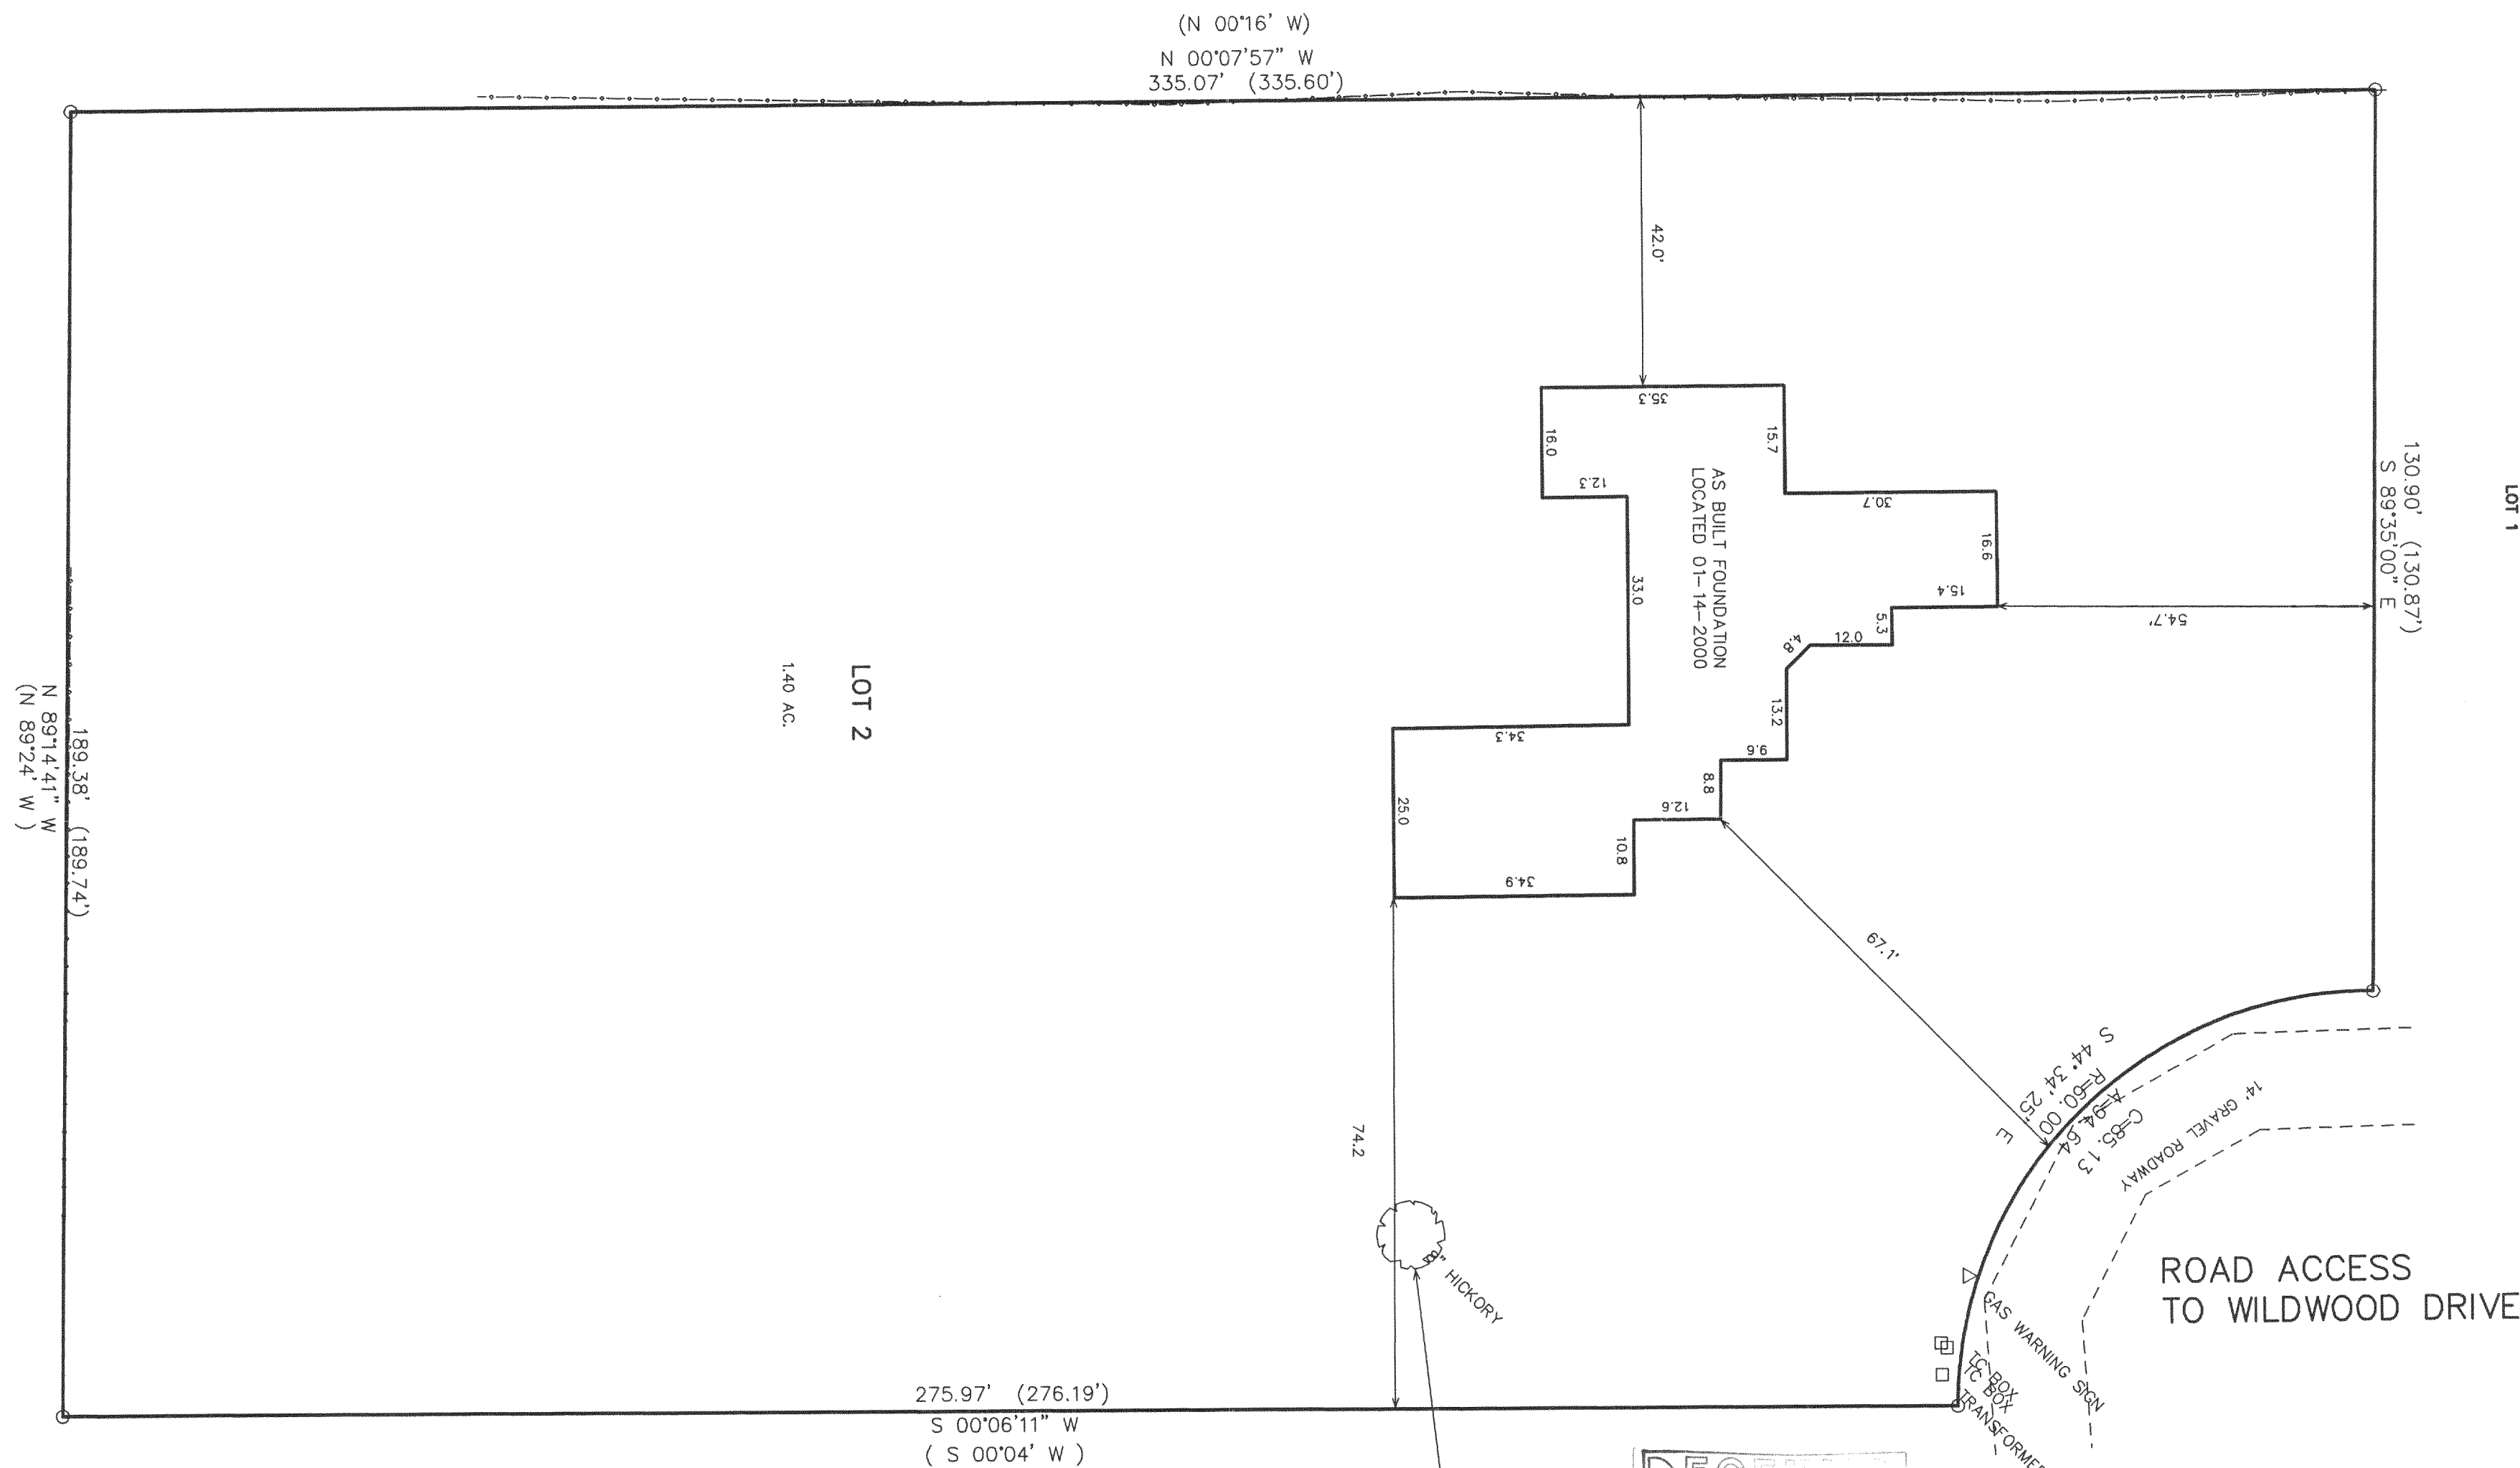


PLAT OF SURVEY  
LOT 2 OF CERTIFIED SURVEY MAP NO. 115

PART OF THE SECTION 34  
TOWN 2 NORTH, RANGE 17 EAST  
WALWORTH COUNTY, WISCONSIN

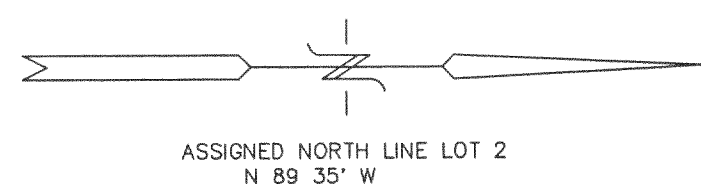

LEGEND

- = FOUND IRON PIPE STAKE
- = FOUND IRON REBAR STAKE
- (xxx) = RECORDED AS

BENCH MARK  
NAIL SET IN 8" HICKORY  
ASSIGNED EL. = 100.00'

NOTE: COPIES OF THIS MAP TO WHICH THE FOLLOWING  
CERTIFICATE WILL APPLY SHOW SURVEYOR'S ORIGINAL SEAL  
AND SIGNATURE IN RED INK. COPIES BY ANY OTHER MEANS  
MAY HAVE ALTERATIONS WHICH DO NOT REPRESENT THE  
SURVEYOR'S WORK PRODUCT.

I HEREBY CERTIFY THAT THE ABOVE DESCRIBED PROPERTY HAS  
BEEN SURVEYED UNDER MY DIRECTION AND THAT THE ABOVE MAP  
IS A TRUE REPRESENTATION THEREOF AND SHOWS THE SIZE AND  
LOCATION OF THE PROPERTY AND ITS EXTERIOR BOUNDARIES.  
THIS SURVEY IS MADE FOR THE USE OF THE PRESENT OWNERS  
OF THE PROPERTY, AND ALSO THOSE WHO PURCHASE, MORTGAGE,  
OR GUARANTEE THE TITLE THERETO WITHIN ONE YEAR FROM THE  
DATE HEREOF.

DATED: 10-11-99

*Peter S. Gordon*  
PETER S. GORDON R.L.S. 2101

REVISED 01-17-2000  
TO SHOW SIZE & LOCATION OF  
FOUNDATION AS BUILT

WORK ORDERED BY:  
GENEVA HOMES

P.O. BOX 877  
WILLIAMS BAY, WI. 53191

FARRIS, HANSEN & ASSOCIATES, INC.  
Engineering, Architecture, Surveying  
7 Ridgway Court P.O. Box 437  
ELKHORN, WISCONSIN 53121

Office: (414) 723-2098  
Fax: (414) 723-5886

REVISIONS

PROJECT NO.  
5402  
DATE:  
10-10-99  
SHEET NO.  
1 OF 1

JAN 17 2000

JA-115-2 217-1887