

HAROLD H. KOLB
 REGISTERED PROFESSIONAL LAND SURVEYOR
 TWIST BUILDING
 LAKE GENEVA, WIS. 53147

NORTH 1/4 CORNER SECTION 25-2-17

N.E. CORNER SECTION 25-2-17

NORTH LINE SECTION 25-2-17

EAST

1593.38' (1596.60')

(N 1°30'E 1165.48')
 (N 0°29'15"E 1159.69')

(S 89°51'E)
 N 89°13'05"E 300.00'

N 89°13'05"E 100.00'
 (S 89°51'E)

PLAT OF SURVEY OF

A parcel of land located in the Northeast 1/4 of Section 25, T2N, R12E, Walworth County, Wisconsin, described as follows: Commencing at the North-east corner of said Section 25; thence West 1593.38 feet; thence S 0°29'15" E 1159.69 feet; thence S 89°13'05" W 100.00 feet to the place of beginning; thence S 0°29'15" W 1061.48 feet; thence N 89°13'05" W 300.00 feet; thence N 0°29'40" E 1054.34 feet; thence N 89°13'05" E 300.00 feet to the place of beginning, containing 7.29 acres.

Also an easement for ingress and egress to the above parcel which begins at the Southeast corner of said parcel; thence S 0°29'15" E 80.34 feet to the Northerly line of State Highway "36"; thence N 89°20'00" E 23.89 feet along said Highway; thence N 0°29'15" E 93.44 feet to the South line of the above described parcel; thence S 89°24'20" E 20.00 feet along said line to the place of beginning.

NOTE: The North line of Section 25-2-17 is assumed East-West from previous descriptions.

OWNER: Arleigh Kahlke

ACCURACY: Distances ± 0.01'
 Angles ± 05"
 Error of closure less than 1/3000





SCALE 1"=100'

LEGEND

- - Iron Pipe Found
- - Iron Pipe Placed
- - Concrete Monument Found
- () - Described As

CITY OF LAKE GENEVA
 CITY LIMITS

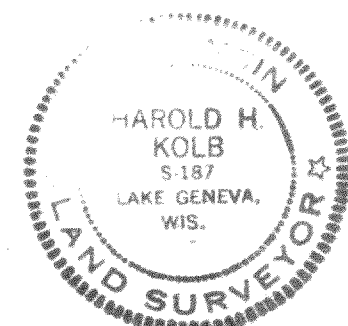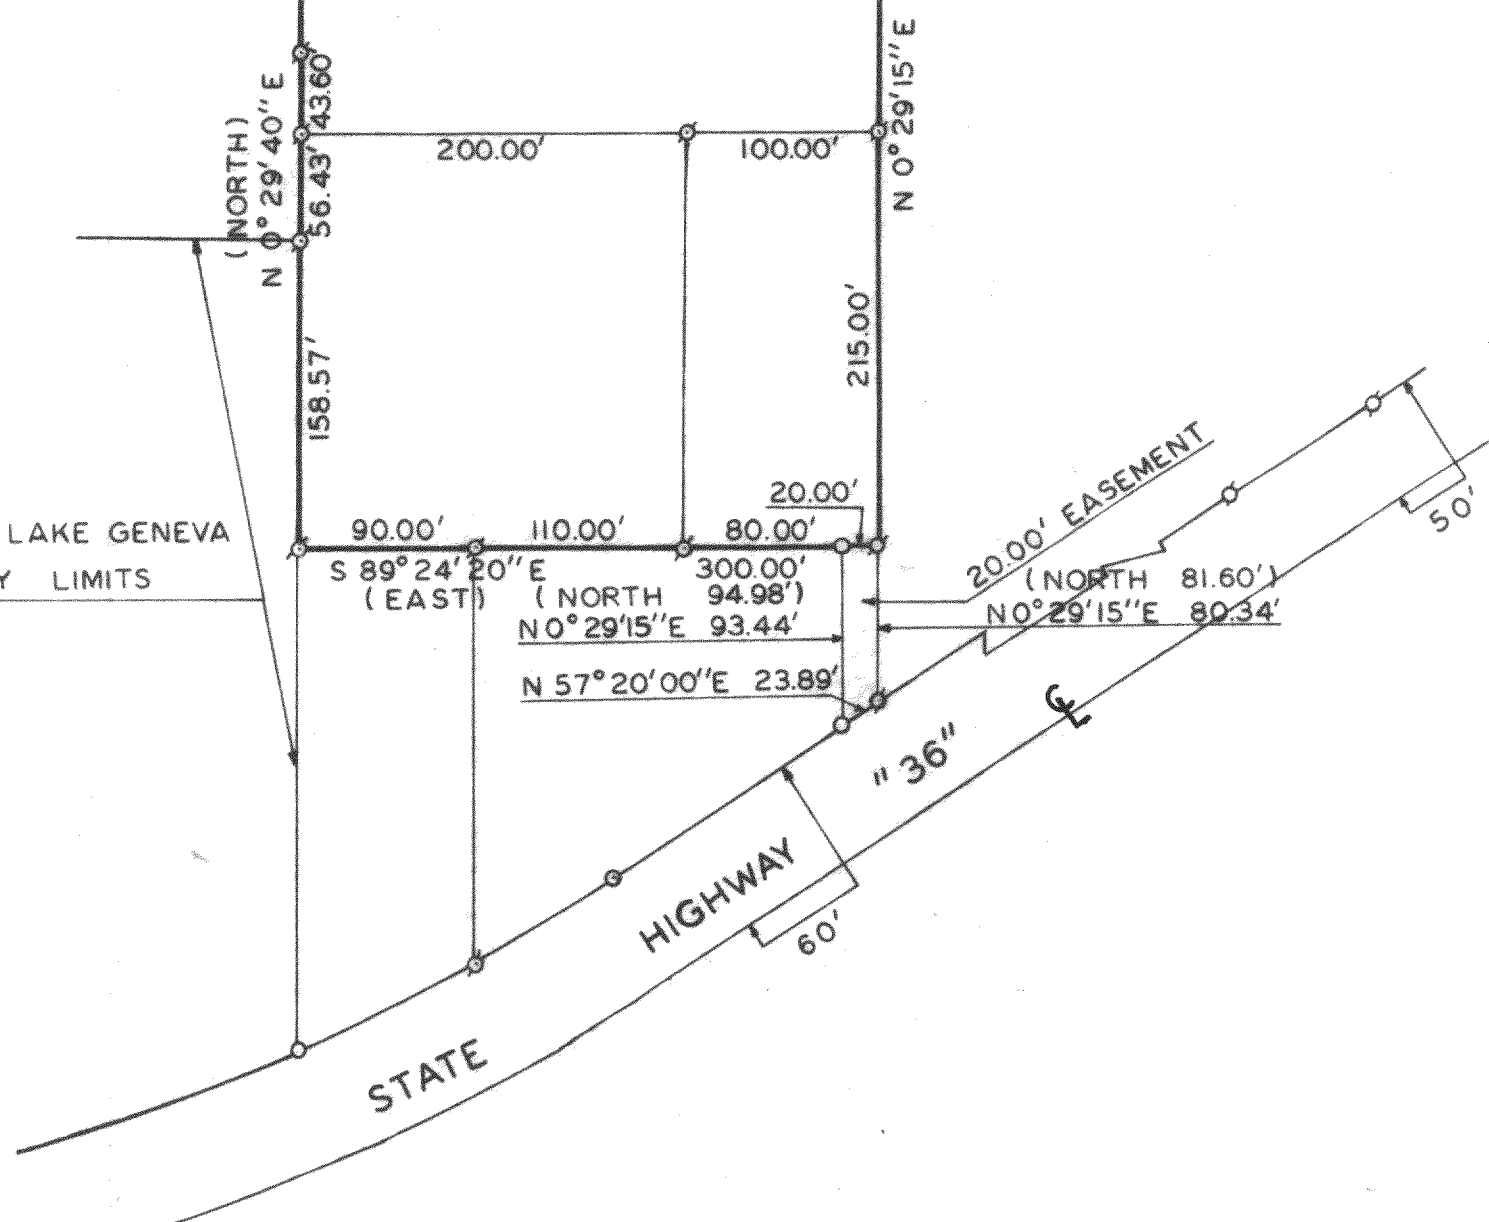

Harold H. Kolb
 Harold H. Kolb
 Wisconsin Registered Land Surveyor, S-187

Date: Nov. 1, 1979

G-25-4
 + in city of Lake Geneva 40p150A+up140B

217-197