



JAN 04 2001

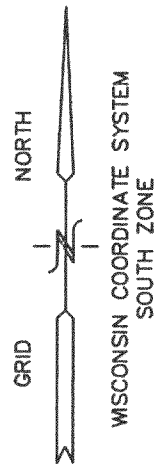

# SITE, GRADING, DRAINAGE, & EROSION CONTROL PLAN

UNIT 04-30  
GENEVA NATIONAL CONDOMINIUM NO. 4  
LOCATED IN TOWN 2 NORTH, RANGE 17 EAST  
WALWORTH COUNTY, WISCONSIN

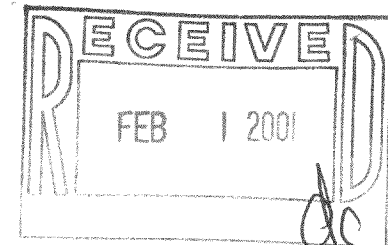

- LEGEND
- = FOUND IRON REBAR STAKE
  - ⦿ = SET IRON REBAR STAKE
  - (XXX) = RECORDED AS
  - XXX --- = EXISTING CONTOURS
  - XXX — = PROPOSED CONTOURS
  - TF=XXXXX = PROPOSED TOP OF FOUNDATION GRADE
  - FF=XXXXX = PROPOSED FIRST FLOOR GRADE
  - WO=XXXXX = PROPOSED WALK-OUT GRADE (BASEMENT)
  - GE=XXXXX = PROPOSED GARAGE ENTRY GRADE




NOTE: COPIES OF THIS MAP TO WHICH THE FOLLOWING CERTIFICATE WILL APPLY SHOW THE SURVEYOR'S ORIGINAL SEAL AND SIGNATURE IN RED INK. COPIES BY ANY OTHER MEANS MAY HAVE ALTERATIONS WHICH DO NOT REPRESENT THE SURVEYOR'S WORK PRODUCT.

I HEREBY CERTIFY THAT THE ABOVE DESCRIBED PROPERTY HAS BEEN SURVEYED UNDER MY DIRECTION AND THAT THE ABOVE MAP IS A TRUE REPRESENTATION THEREOF AND SHOWS THE SIZE AND LOCATION OF THE PROPERTY AND ITS EXTERIOR BOUNDARIES. THIS SURVEY IS MADE FOR THE USE OF THE PRESENT OWNERS OF THE PROPERTY, AND ALSO THOSE WHO PURCHASE, MORTGAGE, OR GUARANTEE THE TITLE THERETO WITHIN ONE YEAR FROM THE DATE HEREOF.

DATED: 05-19-2000

*Peter S. Gordon*  
PETER S. GORDON R.L.S. 2101

REVISED 01-04-2001  
TO SHOW SIZE & LOCATION OF  
RESIDENCE AS BUILT

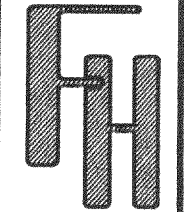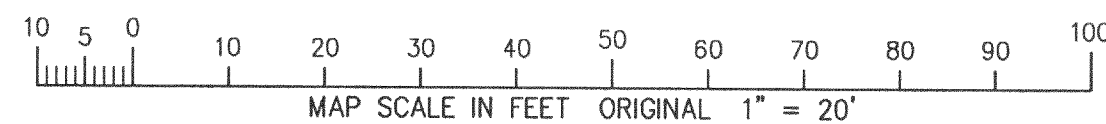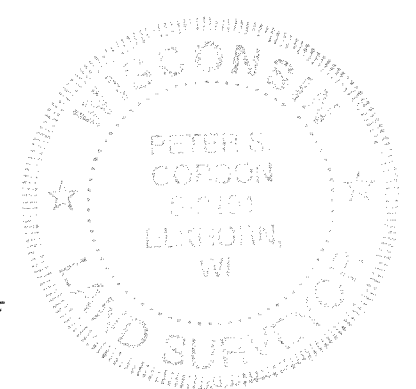

SITE, GRADING, DRAINAGE,  
& EROSION CONTROL PLAN

WORK ORDERED BY -  
SANCTUARY HOMES  
121 WOLF RUN SUITE 4  
MUKWONAGO, WI. 53149

FARRIS, HANSEN & ASSOCIATES, INC.  
Engineering, Architecture, Surveying  
7 Ridgway Court P.O. Box 437  
ELKHORN, WISCONSIN 53121  
Office: (414) 723-2098  
Fax: (414) 723-5886

REVISIONS

PROJECT NO.  
3269.04-30  
DATE:  
05/19/2000  
SHEET NO.  
1 OF 1

JGN-4-30  
217-2022