
## WALWORTH COUNTY SURVEYING & MAPPING

P. O. BOX 1115 LAKE GENEVA, WISCONSIN 414-248-0505



## SOUTH VIEW DRIVE

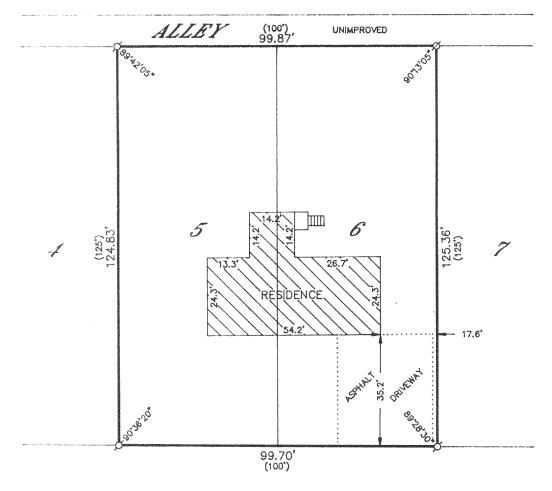

## PLAT OF SURVEY OF

LOTS 5 AND 6, BLOCK 28 OF SUNSET HILLS, A SUBDIVISION LOCATED IN SECTION 33, T 2 N, R 17 E, WALWORTH COUNTY, WISCONSIN.

ORDERED BY; COLDWELL BANKER
GENEVA LAKES AREA REALTORS

GENEVA LAKES AREA REALTORS 838 MAIN STREET LAKE GENEVA, WISCONSIN

53147

I HEREBY CERTIFY THAT I HAVE SURVEYED THE ABOVE DESCRIBED PROPERTY AND THAT THE ABOVE DESCRIBED AROPERS AND LOCATION OF THE PROPERTY, ITS EXTERIOR BOUNDARIES, THE LOCATION OF ALL VISIBLE STRUCTURES AND DIMENSIONS OF ALL PRINCIPAL BUILDINGS THEREON, BOUNDARY FENCES, APPARENT EASEMENTS, ROADWAYS AND VISIBLE ENGRACHMENTS, IF ANY, TO THE BEST OF MY KNOWLEDGE AND BELIEF.

THIS SURVEY IS MADE FOR THE USE OF THE PRESENT OWNERS OF THE PROPERTY AND ALSO THOSE WHO PURCHASE, MORTGAGE OR GUARANTEE THE TITLE THERETO WITHIN ONE (1) YEAR FROM DATE WESTER

ROBERT M. BAERENNALD

ROBERT M. BAERENWALD WISCONSIN RECUSTERED LAND SURVEYOR. S—15

DATE SEPT - 8 1997

NOTE: THIS IS NOT A CERTIFIED COPY UNLESS SEALED.

SCALE IN FEET

0 30 60

LEGEND

O-IRON PIPE FOUND

P-IRON ROD FOUND

O-IRON PIPE PLACED
()-RECORDED AS

JSH-209 217-2056