
PLAT OF SURVEY -OF-

LOT 1, CERTIFIED SURVEY MAP NO. 2521, RECORDED IN VOLUNME 12 OF CERTIFIED SURVEY MAPS ON PAGES 270-271 AS DOCUMENT NO. 295906 AS RECORDED NOVEMBER 2, 1994, IN THE OFFICE OF THE REGISTER OF DEEDS IN AND FOR WALWORTH COUNTY, WISCONSIN BEING PART OF THE NORTHWEST 1/4 OF THE NORTHEAST 1/4 OF SECTION 13, AND PART OF THE SOUTHWEST 1/4 OF THE SOUTHEAST 1/4 OF SECTION 12, ALL IN TOWNSHIP 2 NORTH, RANGE 17 EAST OF THE FOURTH PRINCIPAL MERIDIAN, IN THE TOWN OF GENEVA, WALWORTH COUNTY WISCONSIN WALWORTH COUNTY, WISCONSIN.


SURVEY FOR: DAVID AND RENATA MEIER SURVEY LOCATION: W. 2612 SPRINGFIED ROAD

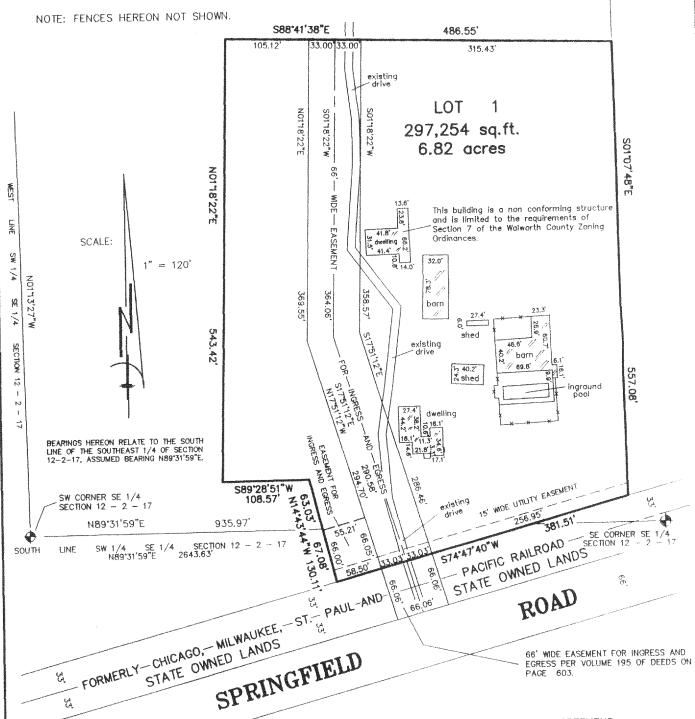

"I hereby certify that I have surveyed the above described property and that the above map is a correct representation thereof and shows the size and location of the property, its exterior boundaries, the location of all visible structures and dimensions of all principal buildings thereon, boundary fences, apparent easements, roadways and encroachments, if any."

"This survey is made for the use of the present owners of the property, and those who purchase, mortgage, or guarantee the title thereto within one year from date hereof."

MONUMENTATION BY WRITTEN AGREEMENT WITH THE ABOVE NAMED CLIENT HAS BEEN WAIVED IN ACCORDANCE WITH A-E 7.01(2) OF THE WISCONSIN ADMINISTRATIVE CODE

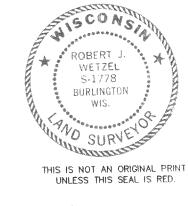

THIS IS NOT AN ORIGINAL PRINT UNLESS THIS SEAL IS RED.

B.W. SURVEYING, INC.

412 N. PINE STREET BURLINGTON, WI 53105 (262) - 767 - 0225

国(C国I)

FEB 2 7 2002

ROBERT J. WETZEL S-1778

OCTOBER 18, 2001 DATE

5187 JOB NUMBER


217-2225

PLAT OF SURVEY -OF-

LOT 1, CERTIFIED SURVEY MAP NO. 2521, RECORDED IN VOLUNME 12 OF CERTIFIED SURVEY MAPS ON PAGES 270-271 AS DOCUMENT NO. 295906 AS RECORDED NOVEMBER 2, 1994, IN THE OFFICE OF THE REGISTER OF DEEDS IN AND FOR WALWORTH COUNTY, WISCONSIN BEING PART OF THE NORTHWEST 1/4 OF THE NORTHEAST 1/4 OF SECTION 13, AND PART OF THE SOUTHWEST 1/4 OF THE SOUTHEAST 1/4 OF SECTION 12, ALL IN TOWNSHIP 2 NORTH, RANGE 17 EAST OF THE FOURTH PRINCIPAL MERIDIAN, IN THE TOWNSHIP 2

WALWORTH COUNTY, WISCONSIN.

SURVEY FOR: DAVID AND RENATA MEIER SURVEY LOCATION: W. 2612 SPRINGFIED ROAD

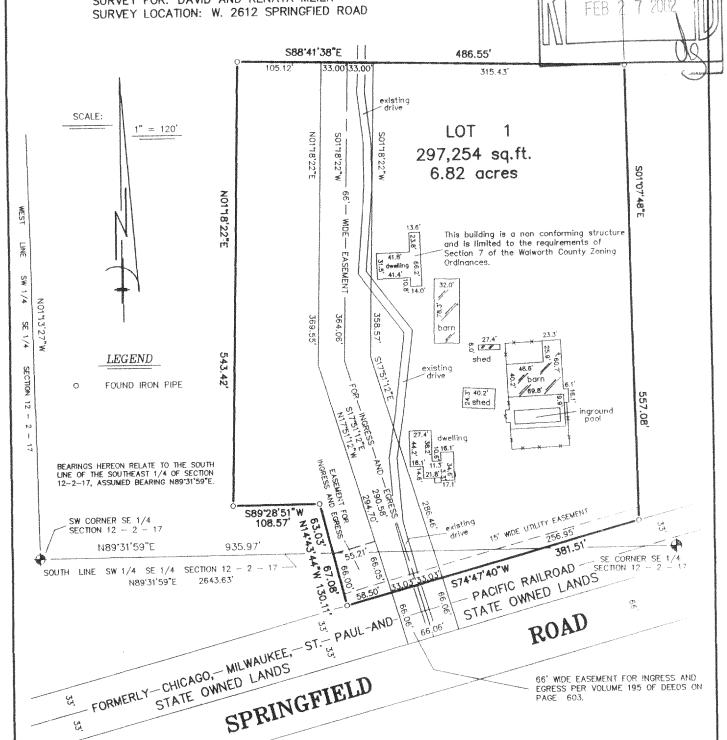

NOTE: FENCES HEREON NOT LOCATED.

"I hereby certify that I have surveyed the above described property and that the above map is a correct representation thereof and shows the size and location of the property, its exterior boundaries, the location of all visible structures and dimensions of all principal buildings thereon, boundary fences, apparent easements, roadways and encroachments, if any."

"This survey is made for the use of the present owners of the property, and those who purchase, mortgage, or guarantee the title thereto within one year from date hereof."



THIS IS NOT AN ORIGINAL PRINT UNLESS THIS SEAL IS RED.



B.W. SURVEYING, INC.

412 N. PINE STREET BURLINGTON, WI 53105 (262)-767-0225

FRANKLIN J. LEHMAN

S-2211

5187

REVISED: NOVEMBER 2, 2001 OCTOBER 18, 2001

JOB NUMBER

JA-2521-1