
## PLAT OF SURVEY

- OF -

J.K. SURVEYING INC. N3705 WILLOWBEND LANE LAKE GENEVA, WI, 53147 262-248-3697

LOTS 9303 - 9307 BLOCK 167 OF LAKE COMO BEACH SUBDIVISION; LOCATED IN TOWN 2 NORTH, RANGE 17 EAST, WALWORTH COUNTY, WISCONSIN



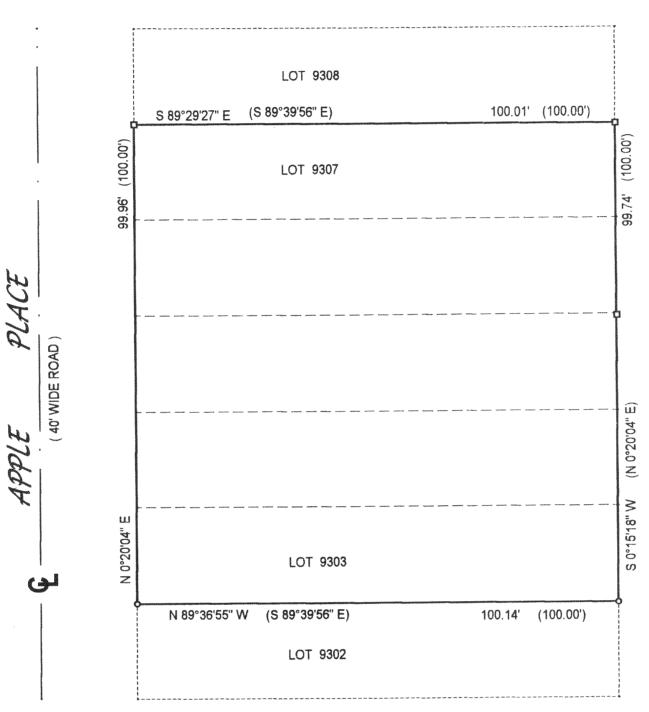

( )= recorded as

= found iron bar

= found iron pipe

= set iron pipe

= set iron bar

SCALE 1" = 20"

"I hereby certify that I have surveyed the above described property and that the above map is a true representation thereof and shows the size and location of all visible structures, apparent easements and encroachments

JOB # 02-029 if a

This survey is made for the present owners of the property, and those who purchase, mortgage, or guarantee the title thereto, within one year from the date hereof.

TAX ID # JLCB 2005

COMPARE LEGAL DESCRIPTION ABOVE AND DRAWING WITH DEED, FOR BUILDING RESTRICTIONS AND EASEMENTS NOT SHOWN, REFER TO DEED, ABSTRACT SOURCES AND LOCAL MUNICIPAL CODES. NOTIFY THE SURVEYOR IMMEDIATELY OF ANY DISCREPANCY.

John Plhoto

JOHN P.
KROTT
S-2258
MUKWONAGO,
WIS.

SURVE

JOHN KROTT S - 2258 Wisconsin Registered Land Surveyor ( original if signed in red )

DATED THIS THE 1st DAY OF FEBRUARY 2002.