




# PLAT OF SURVEY

## PARCEL 1

Lot 2 and Outlot 2 of Certified Survey Map No. 1521 dated August 1, 1986 recorded August 6, 1986 in Volume 7 of Certified Survey Maps on page 132, Document No. 133919, Walworth County Records.

## PARCEL 2

A parcel of land located in the Southeast Quarter of Section 28, Township 2 North, Range 17 East, Walworth County, Wisconsin, being part of a 20 foot wide roadway shown on the recorded Plat of Lackey Johnson Subdivision, and described as follows: Beginning at the Southeast corner of Lot 2 of Certified survey Map No. 1521; thence South 15 degrees 04 minutes 01 seconds East, 20.00 feet to the Northeast corner of Outlot 2 of said Certified Survey Map; thence along the arc of a curve to the left, 50.44 feet, the radius being 11509.16 feet and the chord bearing South 74 degrees 48 minutes 27 seconds West, 50.44 feet to the Northwest corner of Outlot 2 of said Certified Survey Map; thence North 15 degrees 19 minutes 05 seconds West, 20.00 feet to the Southwest corner of Lot 2 of said Certified Survey Map; thence along the arc of a curve to the right, 50.52 feet, the radius being 11529.16 feet and the chord bearing North 74 degrees 48 minutes 27 seconds East, 50.52 feet to the place of beginning.

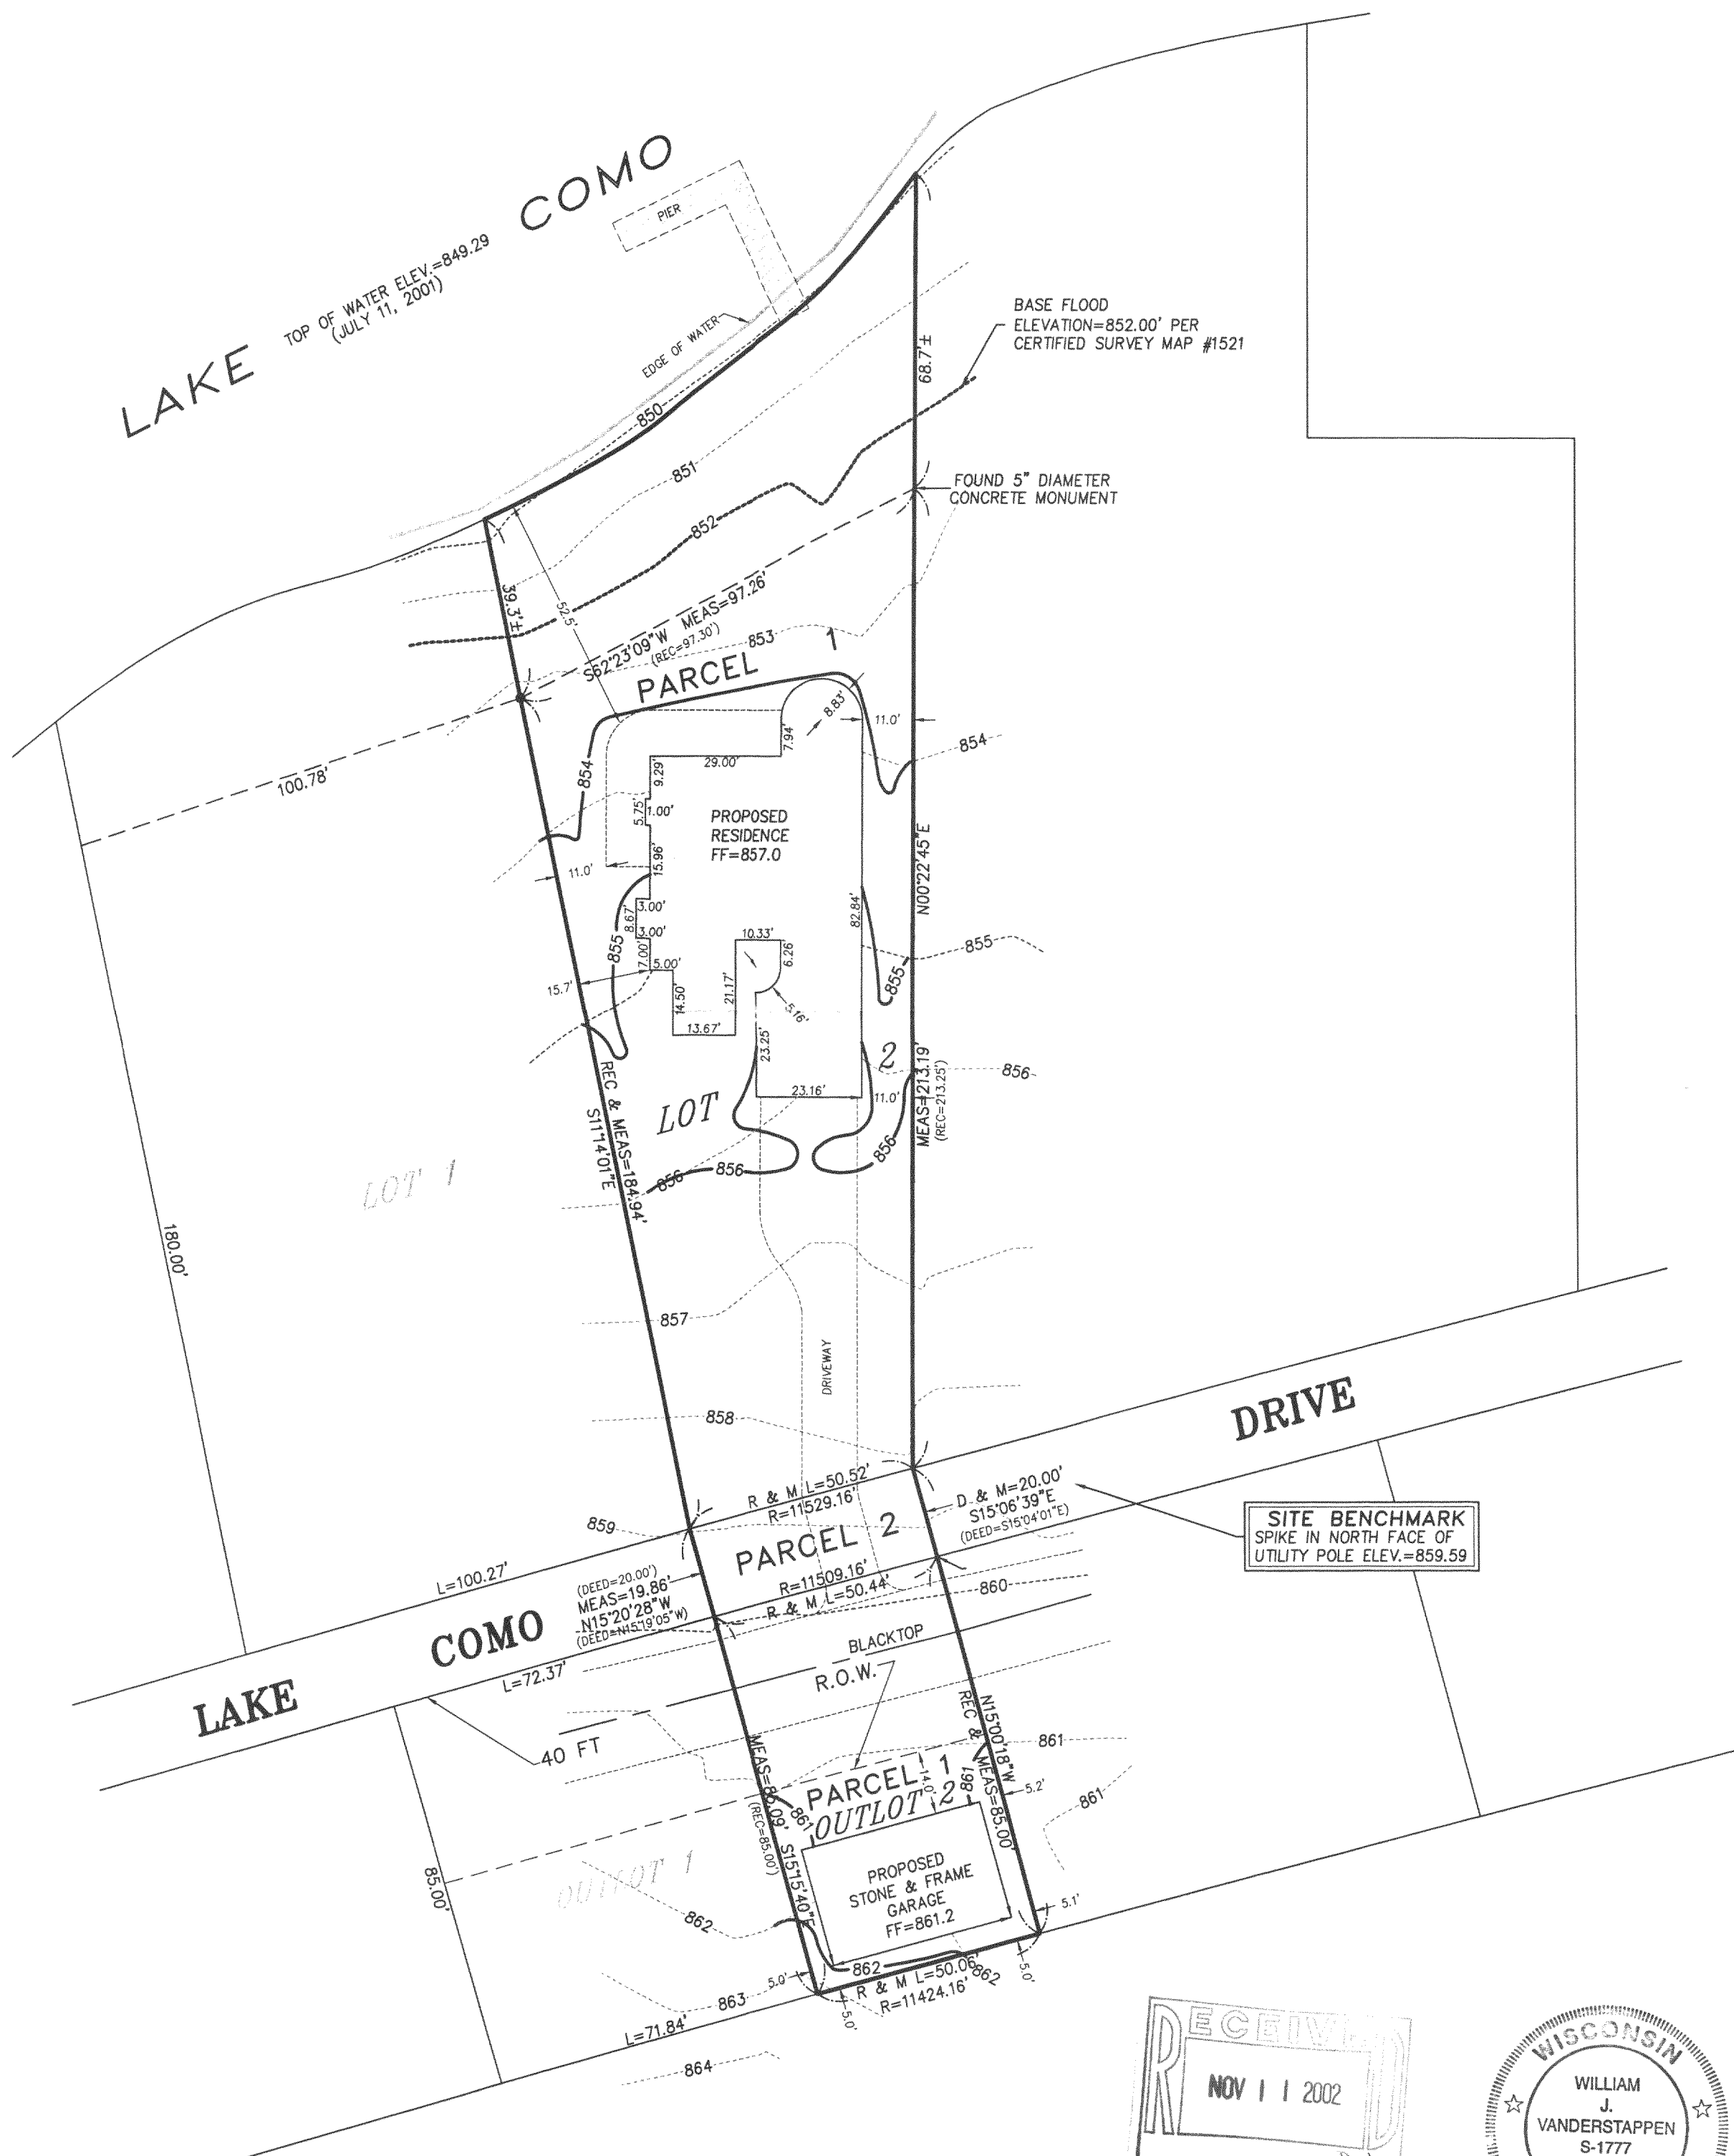

PLAT REVISED 7/16/02

LEGEND	
● FOUND IRON BAR	⊙ SET IRON BAR
⊗ FOUND SPIKE	⊗ SET SPIKE
○ FOUND IRON PIPE	

CLIENT: LINDA DIGANGI

DRAWN BY: ST CHK'ED BY: WJV

SCALE: 1"=30' SEC. 28 T. 2 R. 17 E.

P.I.N.: GENEVA TWP.-WALWORTH COUNTY

JOB NO.: 010584B I.D. SP BK. PG.

ALL DISTANCES SHOWN IN FEET AND DECIMAL PARTS THEREOF CORRECTED TO 68° F.

NOTE: Only those Building Line Restrictions or Easements shown on a Recorded Subdivision Plat are shown hereon unless the description ordered to be surveyed contains a proper description of the required building lines or easements.

- \* No distance should be assumed by scaling.
- \* No underground improvements have been located unless shown and noted.
- \* No representation as to ownership, use, or possession should be hereon implied.
- \* This Survey and Plat of Survey are void without original embossed or colored seal and signature affixed.

Compare your description and site markings with this plat and AT ONCE report any discrepancies which you may find.



STATE OF ILLINOIS )  
COUNTY OF McHENRY ) S.S.


I hereby certify that we have surveyed the premises above described, and that the plat hereon is a true representation of the said survey.

Dated at Woodstock, McHenry County, Illinois 7/10 A.D., 2002.

VANDERSTAPPEN SURVEYING, INC.

By: *William J. Vanderstappen*  
Wisconsin Registered Land Surveyor, No. 1777 S


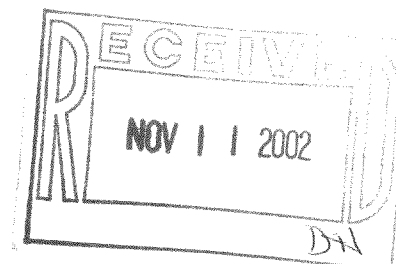
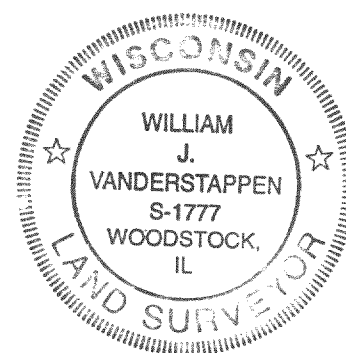


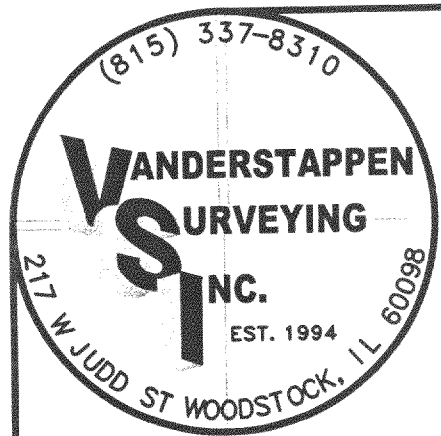

# PLAT OF SURVEY

PARCEL 1  
Lot 2 and Outlot 2 of Certified Survey Map No. 1521 dated August 1, 1986 recorded August 6, 1986 in Volume 7 of Certified Survey Maps on page 132, Document No. 133919, Walworth County Records.

PARCEL 2  
A parcel of land located in the Southeast Quarter of Section 28, Township 2 North, Range 17 East, Walworth County, Wisconsin, being part of a 20 foot wide roadway shown on the recorded Plat of Lackey Johnson Subdivision, and described as follows: Beginning at the Southeast corner of Lot 2 of Certified survey Map No. 1521; thence South 15 degrees 04 minutes 01 seconds East, 20.00 feet to the Northeast corner of Outlot 2 of said Certified Survey Map; thence along the arc of a curve to the left, 50.44 feet, the radius being 11509.16 feet and the chord bearing South 74 degrees 48 minutes 27 seconds West, 50.44 feet to the Northwest corner of Outlot 2 of said Certified Survey Map; thence North 15 degrees 19 minutes 05 seconds West, 20.00 feet to the Southwest corner of Lot 2 of said Certified Survey Map; thence along the arc of a curve to the right, 50.52 feet, the radius being 11529.16 feet and the chord bearing North 74 degrees 48 minutes 27 seconds East, 50.52 feet to the place of beginning.

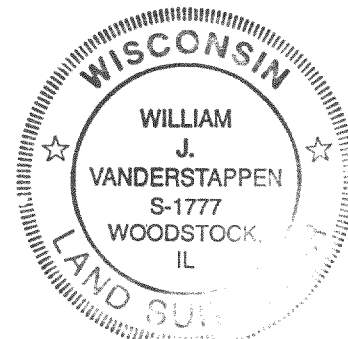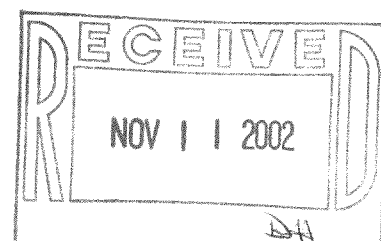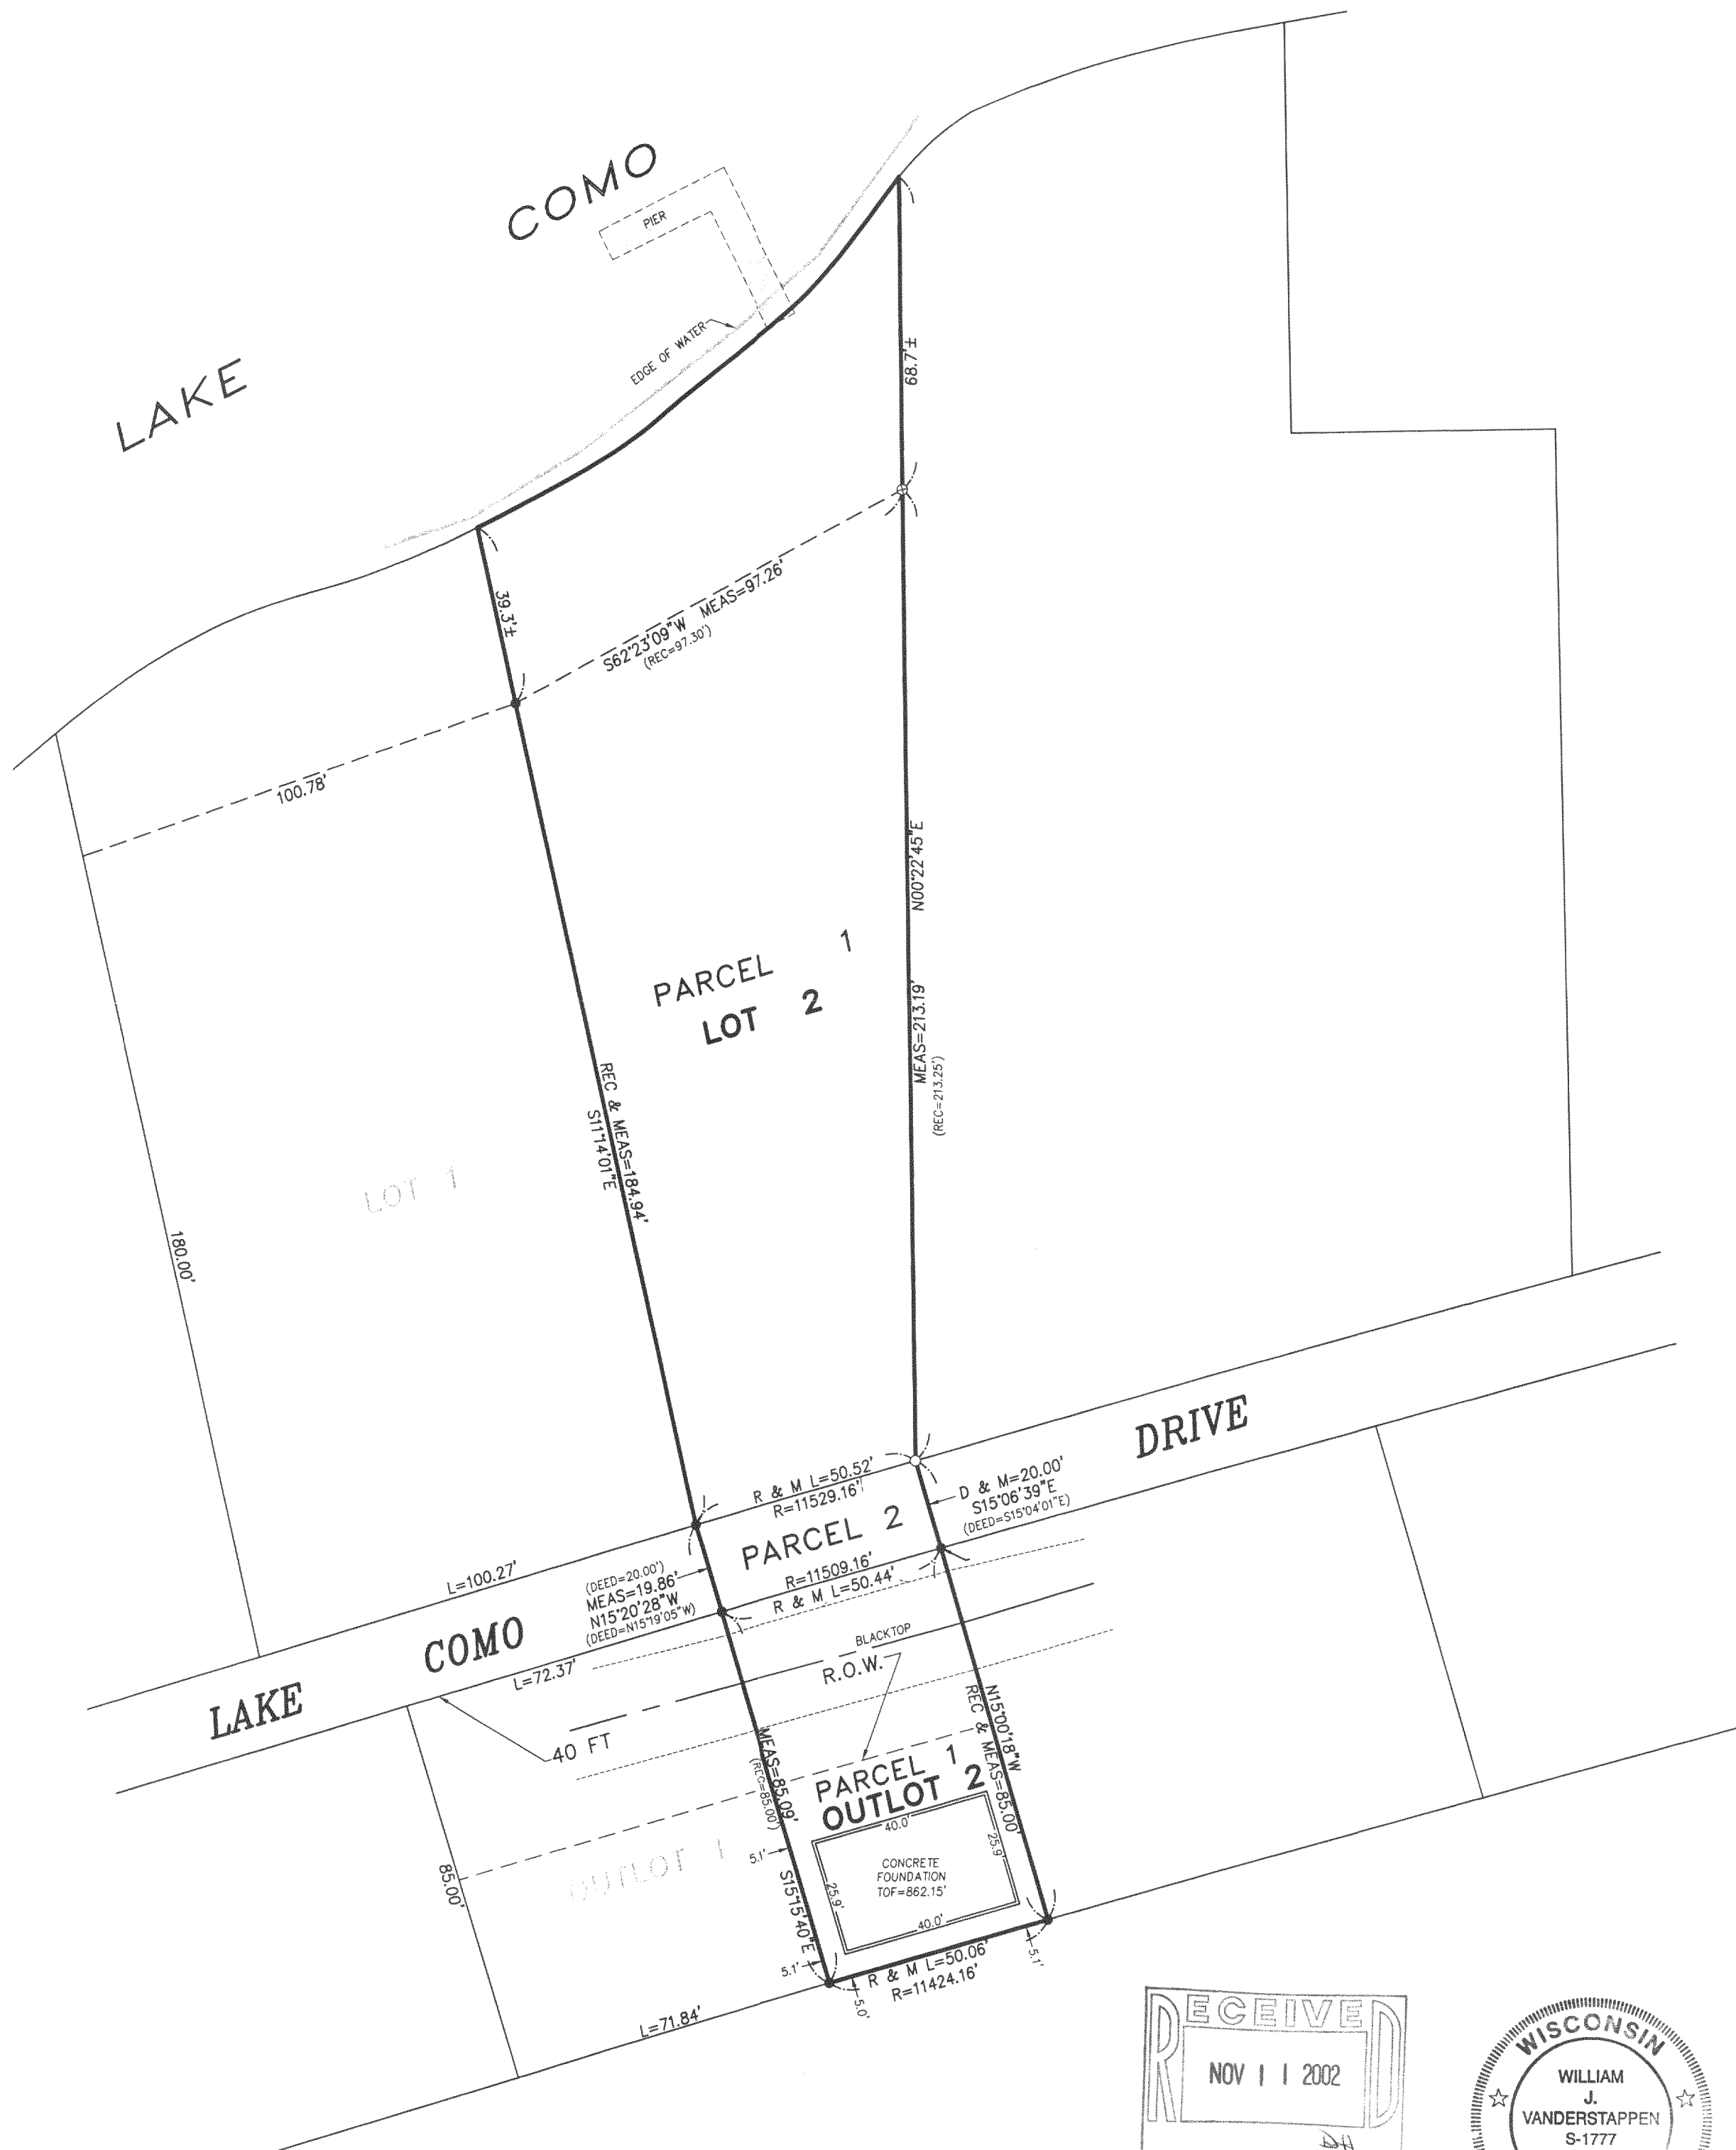

LEGEND	
● FOUND IRON BAR	⊙ SET IRON BAR
⊗ CONC MONUMENT	⊗ SET SPIKE
○ FOUND IRON PIPE	

CLIENT: LINDA DIGANGI  
DRAWN BY: RSL CHK'ED BY: WJV  
SCALE: 1"=30' SEC. 28 T. 2 R. 17 E.  
P.I.N.: GENEVA TWP.-WALWORTH COUNTY  
JOB NO.: 010584C I.D. FND BK. 42 PG. 37  
ALL DISTANCES SHOWN IN FEET AND DECIMAL PARTS THEREOF  
CORRECTED TO 68° F.

NOTE: Only those Building Line Restrictions or Easements shown on a Recorded Subdivision Plat are shown hereon unless the description ordered to be surveyed contains a proper description of the required building lines or easements.  
\* No distance should be assumed by scaling.  
\* No underground improvements have been located unless shown and noted.  
\* No representation as to ownership, use, or possession should be hereon implied.  
\* This Survey and Plat of Survey are void without original embossed or colored seal and signature affixed.

Compare your description and site markings with this plat and AT ONCE report any discrepancies which you may find.

STATE OF ILLINOIS )  
COUNTY OF McHENRY ) S.S.

I hereby certify that we have surveyed the premises above described, and that the plat hereon is a true representation of the said survey.

Dated at Woodstock, McHenry County, Illinois 8/27 A.D., 2002.  
VANDERSTAPPEN SURVEYING, INC.

By: *William J. Vanderstappen*  
Wisconsin Registered Land Surveyor, No. 1777 S

JA1521-2  
JA1521-4

217-2418