


SITE, GRADING, DRAINAGE, & EROSION CONTROL PLAN

UNIT 25-15 GENEVA NATIONAL CONDOMINIUM NO. 25

LOCATED IN TOWN 2 NORTH, RANGE 17 EAST, WALWORTH COUNTY, WISCONSIN

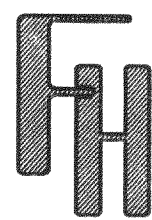


WORK ORDERED BY: CHARLES MILES
7830 PILLOW HILL ROAD
SPRING GROVE, IL 60081

FARRIS, HANSEN & ASSOCIATES, INC.
Engineering, Architecture, Surveying
7 Ridgeway Court P.O. Box 437
ELKHORN, WISCONSIN 53121
Office: (262) 723-2098
Fax: (262) 723-5886

REVISIONS

PROJECT NO.
3269.25-15
DATE:
04/12/2002
SHEET NO.
1 OF 1

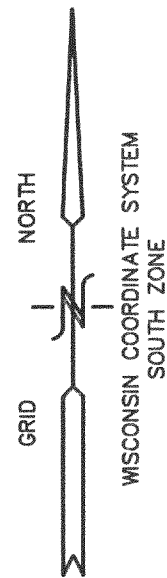

CONDOMINIUM NO. 26
(FUTURE G.N. DEVELOPMENT)

UNIT 25-15
22,474 S.F.

UNIT 25-14

UNIT 25-16

AS BUILT
RESIDENCE

EAST EDGE TREES
& BRUSH

PROPOSED
PAVED
DRIVE

PROPOSED
TREE WELL

PROPOSED 30'-15" CULVERT
WITH END SECTIONS
SW IE=867.5
NE IE=868.0

TURNBERRY COURT
66' WIDE PRIVATE ROADWAY

LEGEND

- = FOUND IRON REBAR STAKE
- ⊕ = HYDRANT LOCATED
- = SANITARY MANHOLE LOCATED
- (XXX) = RECORDED AS
- XXX --- = EXISTING CONTOURS
- XXX --- = PROPOSED CONTOURS
- S --- = PROPOSED SILT FENCE

FUTURE SANITARY SEWER TO
SERVE CONDOMINIUM 26
(ALLOWED BY GENEVA NATIONAL
COVENANTS, CONDITIONS, AND
RESTRICTIONS)

BENCH MARK
RIM MANHOLE
EL. = 866.28'
(IE = 855.96')

NOTE: COPIES OF THIS MAP TO WHICH THE FOLLOWING CERTIFICATE WILL APPLY SHOW SURVEYOR'S ORIGINAL
SEAL AND SIGNATURE IN RED INK. COPIES BY ANY OTHER MEANS MAY HAVE ALTERATIONS WHICH DO NOT REPRESENT THE SURVEYOR'S
WORK PRODUCT.


I HEREBY CERTIFY THAT THE ABOVE DESCRIBED PROPERTY HAS BEEN SURVEYED UNDER MY DIRECTION AND THAT THE ABOVE MAP IS A TRUE
REPRESENTATION THEREOF AND SHOWS THE SIZE AND LOCATION OF THE PROPERTY AND ITS EXTERIOR BOUNDARIES. THIS SURVEY IS MADE
FOR THE USE OF THE PRESENT OWNERS OF THE PROPERTY, AND ALSO THOSE WHO PURCHASE, MORTGAGE, OR GUARANTEE THE TITLE THERETO
WITHIN ONE YEAR FROM THE DATE HEREOF.

DATE: APRIL 12, 2002

PETER S. GORDON R.L.S. 2101

REVISED 11-07-2002
TO SHOW SIZE & LOCATION OF
AS BUILT RESIDENCE

MAP SCALE IN FEET ORIGINAL 1" = 20'

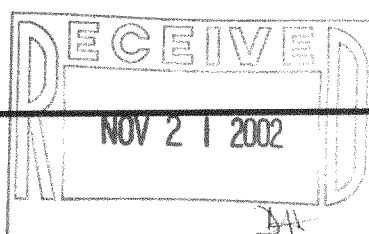

JGN 25-15
217-2429

X:\PROJECTS\3269\CONDO_25\UNIT_15\SCDECP.DCS 04/12/2002

11/21/2002