
PROJECT NO.
3269.20-50
DATE:
09-24-02

DATE: 09-24-02 SHEET NO. 1 OF 1

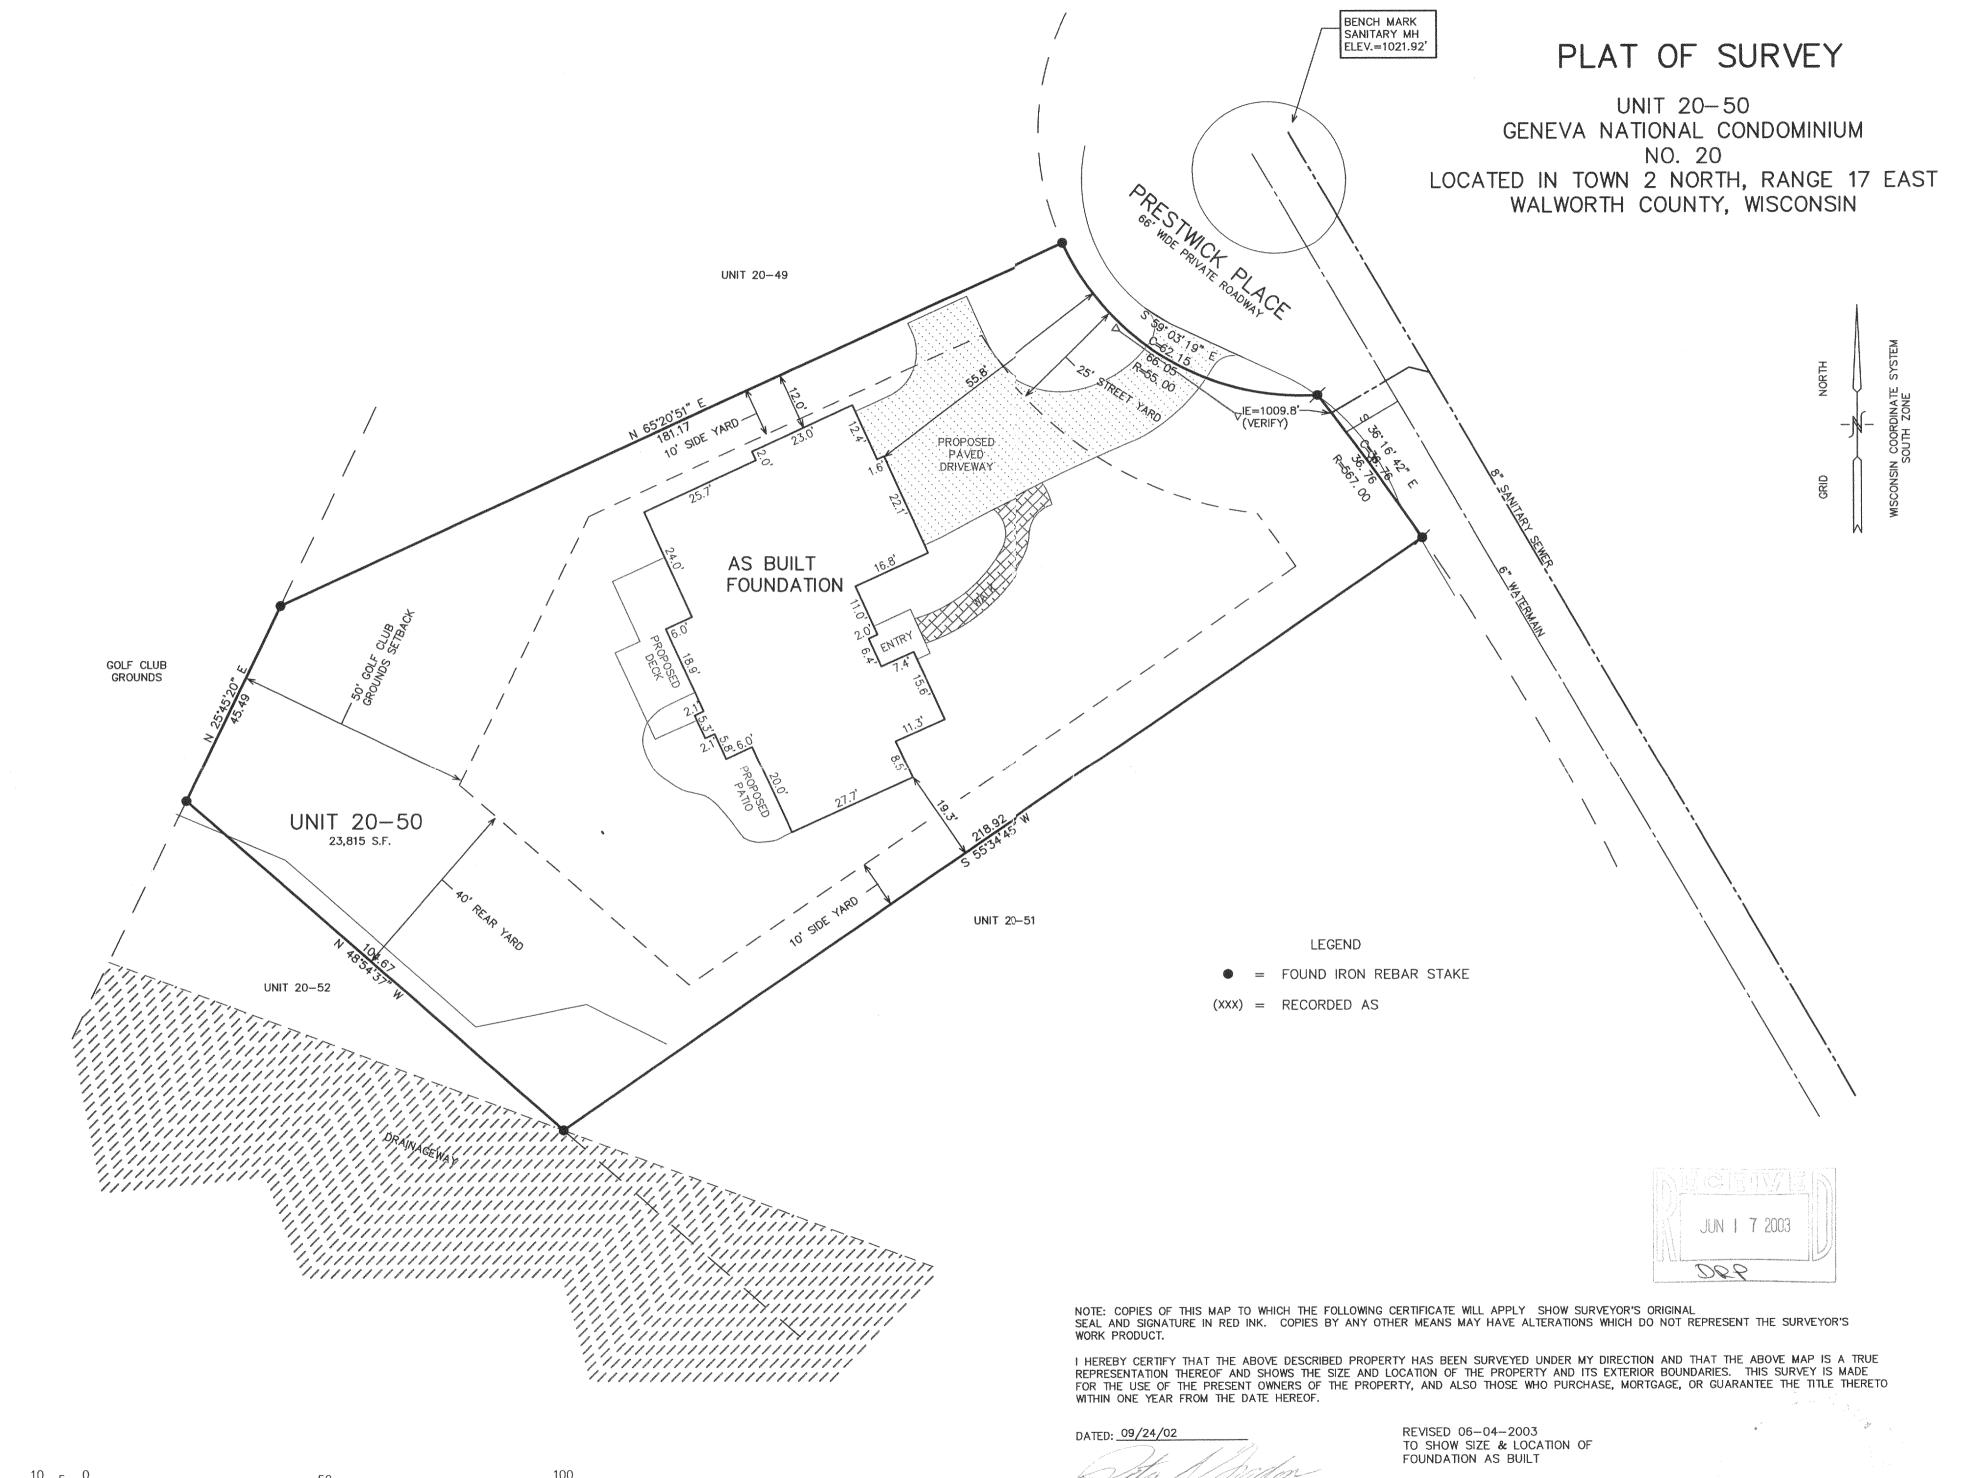

PÉTER S. GORDON R.L.S. 2101

MAP SCALE IN FEET ORIGINAL 1" = 20'