
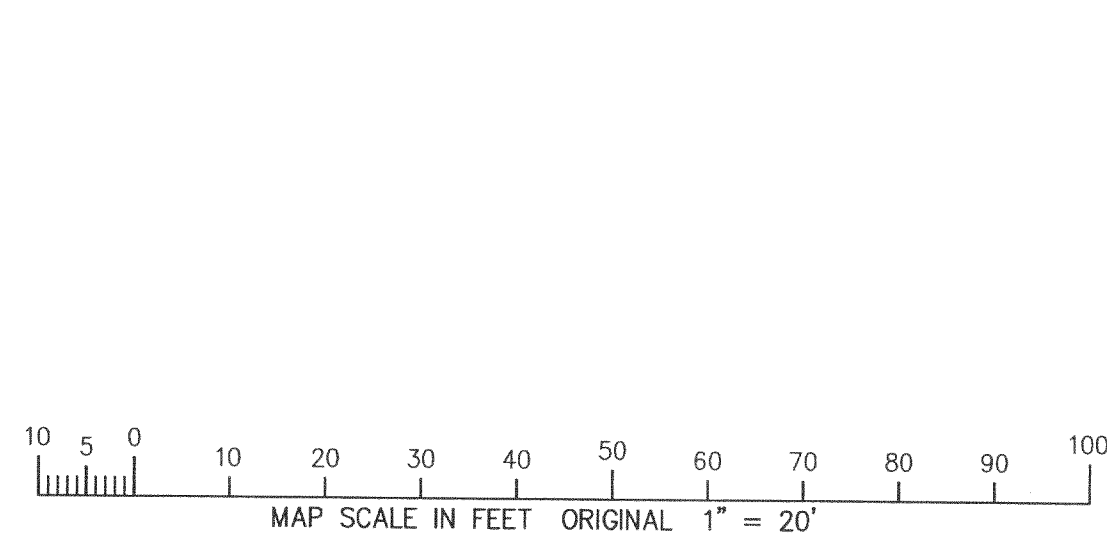


PLAT OF SURVEY
UNIT 38-13
GENEVA NATIONAL CONDOMINIUM NO. 38
LOCATED IN TOWN 2 NORTH, RANGE 17 EAST
WALWORTH COUNTY, WISCONSIN

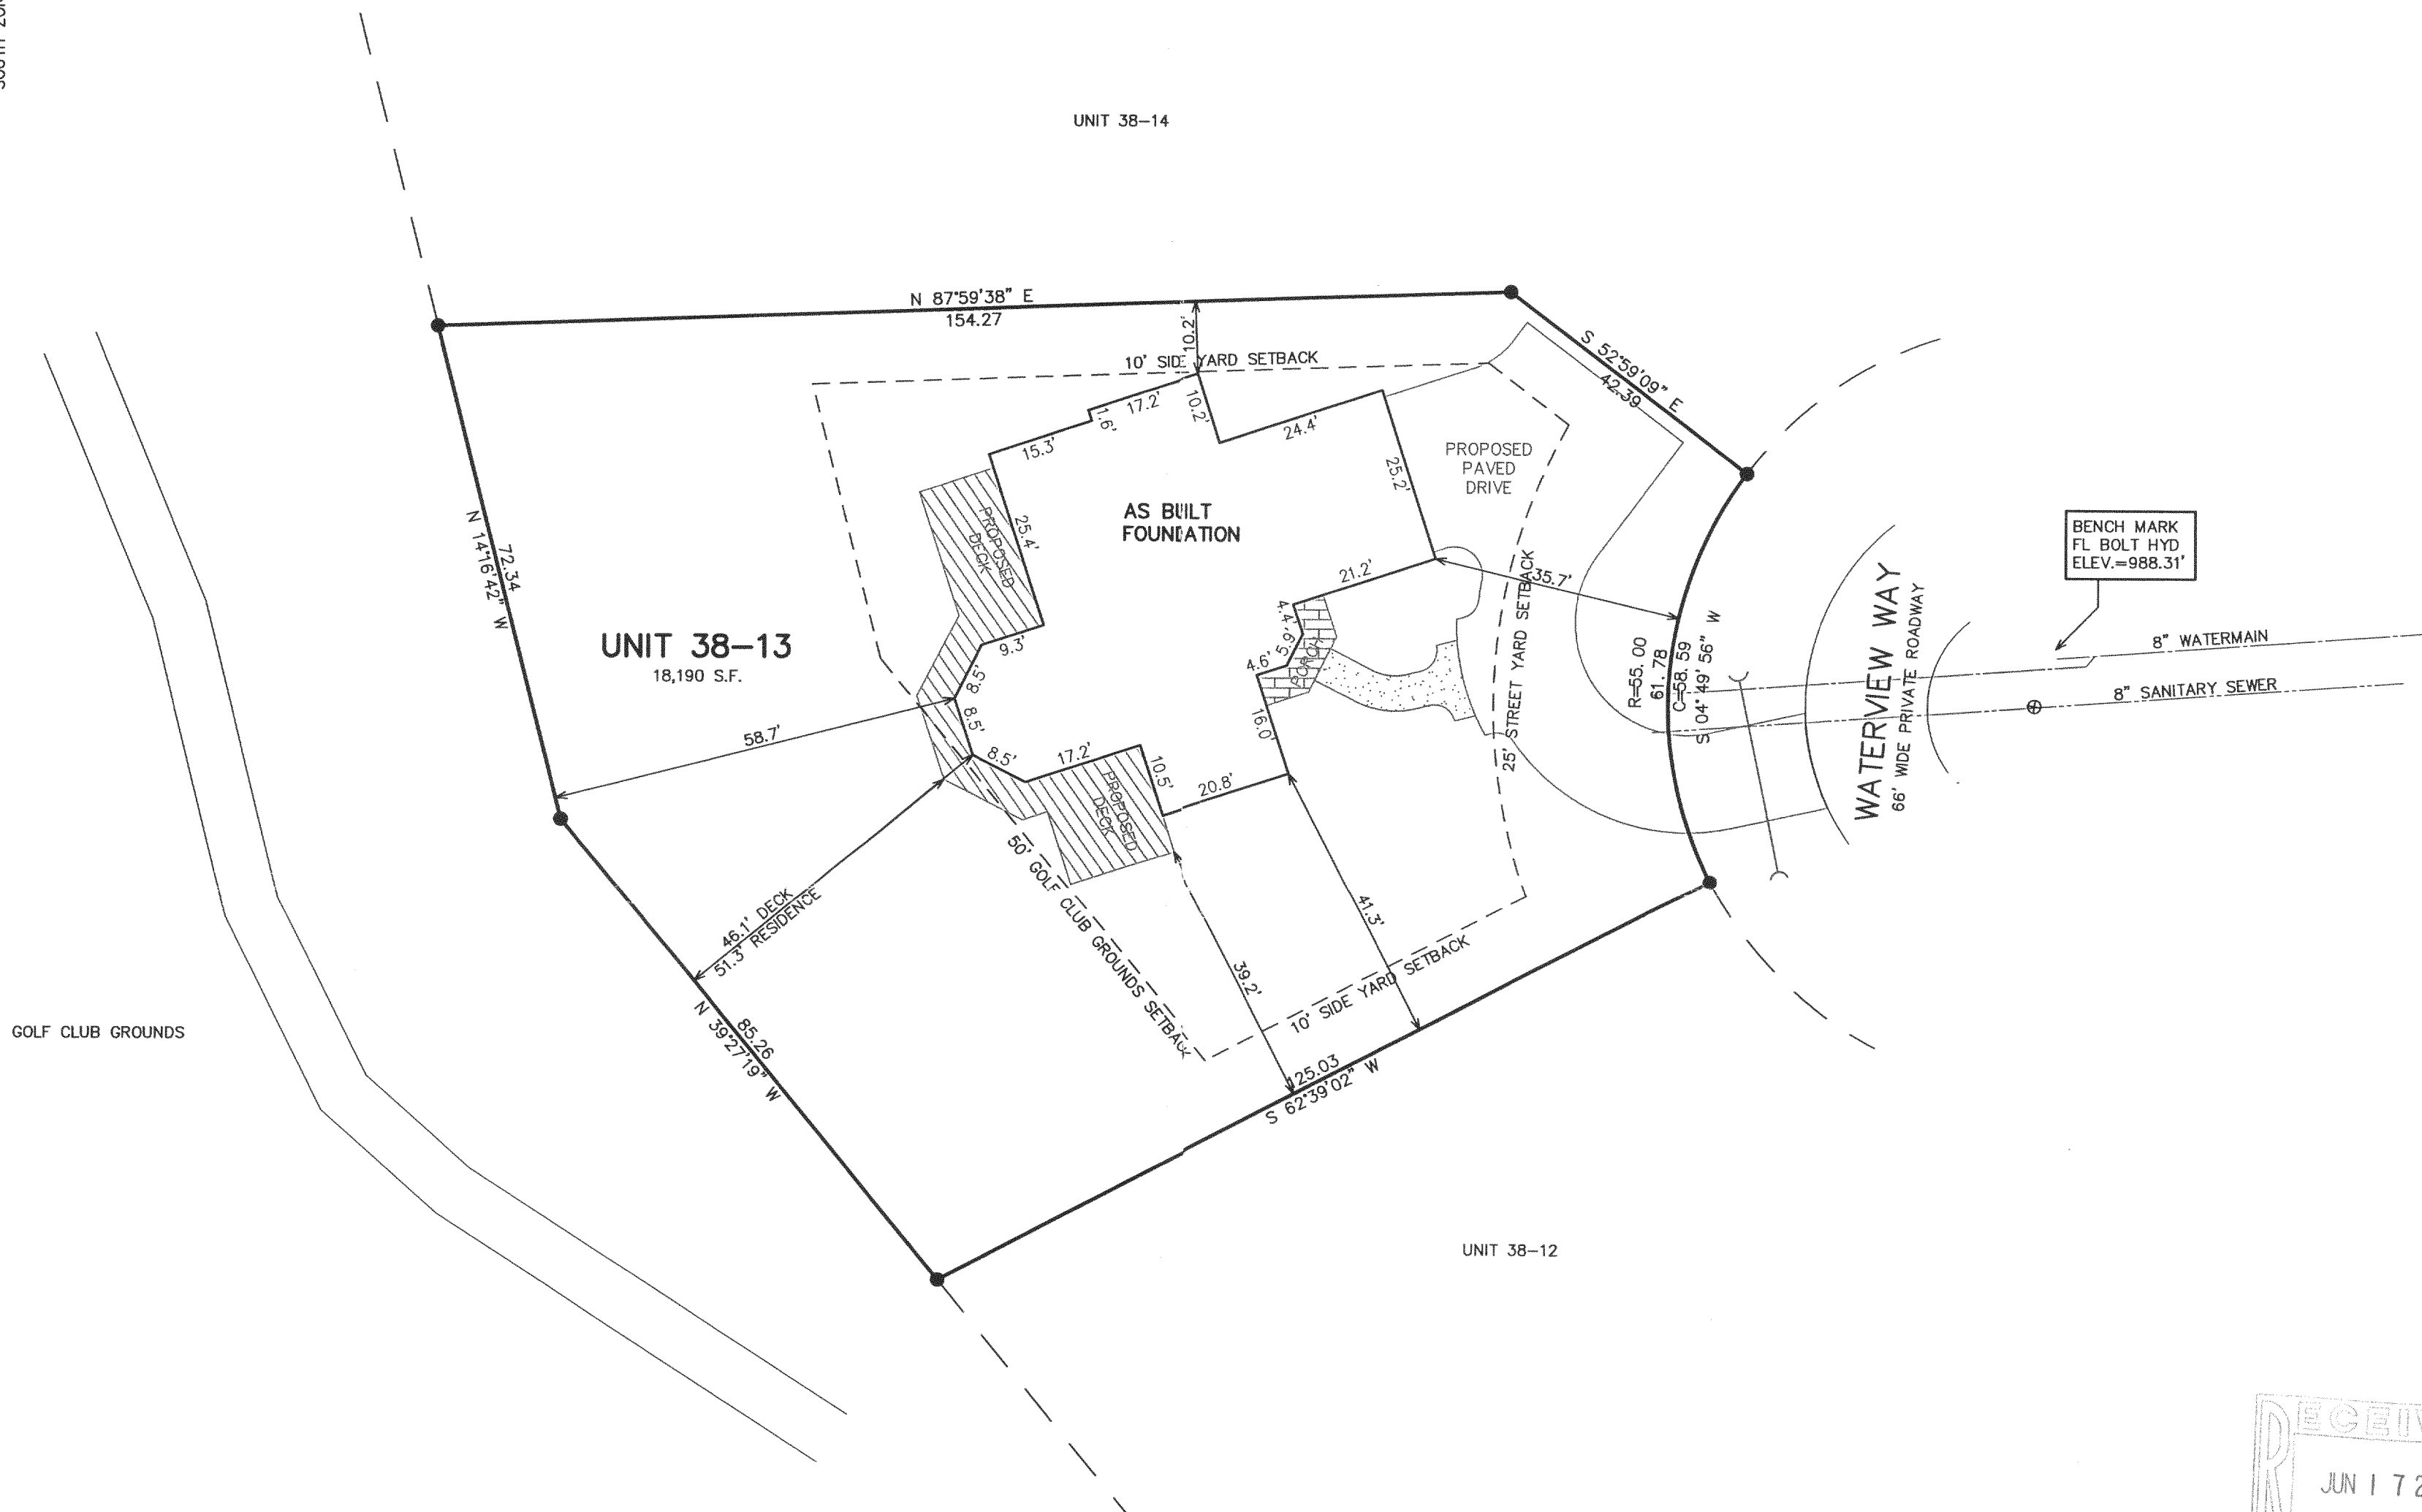

NOTE: COPIES OF THIS MAP TO WHICH THE FOLLOWING CERTIFICATE WILL APPLY SHOW THE SURVEYOR'S ORIGINAL SEAL AND SIGNATURE IN RED INK. COPIES BY ANY OTHER MEANS MAY HAVE ALTERATIONS WHICH DO NOT REPRESENT THE SURVEYOR'S WORK PRODUCT.

I HEREBY CERTIFY THAT THE ABOVE DESCRIBED PROPERTY HAS BEEN SURVEYED UNDER MY DIRECTION AND THAT THE ABOVE MAP IS A TRUE REPRESENTATION THEREOF AND SHOWS THE SIZE AND LOCATION OF THE PROPERTY AND ITS EXTERIOR BOUNDARIES. THIS SURVEY IS MADE FOR THE USE OF THE PRESENT OWNERS OF THE PROPERTY, AND ALSO THOSE WHO PURCHASE, MORTGAGE, OR GUARANTEE THE TITLE THERETO WITHIN ONE YEAR FROM THE DATE HEREOF.

DATED: 07/15/02
PETER S. GORDON R.L.S. 2101

REVISED 06-04-2003
TO SHOW SIZE & LOCATION
OF FOUNDATION AS BUILT

— WORK ORDERED BY —
SCOTT LOWELL — LOWELL MANAGEMENT, INC.
P.O. BOX 926 GENEVA NATIONAL
LAKE GENEVA, WI 53147

FARRIS, HANSEN & ASSOCIATES, INC.
Engineering, Architecture, Surveying
7 Ridgway Court P.O. Box 437
ELKHORN, WISCONSIN 53121
Office: (414) 723-2098
Fax: (414) 723-5886

REVISIONS

9/20/02	— LK
REVISED DECK/ PATIO LAYOUT, ETC.	
04/09/03	— KD
REVISED SITE, GRADING, & EROSION CONTROL PLAN	

PROJECT NO.
3269.38-13

DATE:
08/15/2002

SHEET NO.
1 OF 1

217-2583

J6N 38-13