

"RECERTIFICATION"

PAID

DESCRIPTION: UNIT 20-20 GENEVA NATIONAL CONDOMINIUM NO. 20 as recorded under Document No. 194897. Located in N.W. 1/4 & S.W. 1/4 Section 29, Town 2 North, Range 17 East, in the Town of Geneva, Walworth County, Wisconsin.




RAO. = 55.00

C40. = 63.47

BRG = $N. 72^{\circ} 10' 55'' W.$

1897

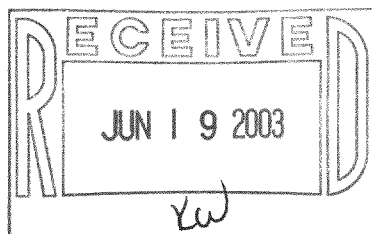


State of Wisconsin)
Milwaukee County) ss

We, Interline Survey Services, Inc., certify that we have surveyed the above described property and the above map is a true representation thereof, and shows the size and location of the property, its exterior boundaries, the location and dimensions of all visible structures thereon, fences, apparent easements and roadways and visible encroachments, if any.

This survey is made for the exclusive use of the present owners of the Property, and also those who purchase, mortgage, or guarantee the title thereto, within one (1) year from date hereof.

Gay J. Smith
Wisconsin Registered Land Surveyor

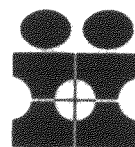

**INTERLINE SURVEY
SERVICES, INC.**

11221 W. FOREST HOME AVE.
FRANKLIN, WISCONSIN 53132
PHONE 425-2060

JOB NO. 29042
DATED: 9/2/02

JGN 20-20

217-2586