

WORK ORDERED BY
VITO STOJIC-VIBENO CONST., LLC
1581 38th AVENUE
KENOSHA, WI 53144

FARRIS, HANSEN & ASSOCIATES, INC.
Engineering, Architecture, Surveying
7 Ridgway Court P.O. Box 437
ELKHORN, WISCONSIN 53121
Office: (262) 723-2098
Fax: (262) 723-5886

REVISIONS
05/14/2003
ADD TOPO
FEATURES

PROJECT NO.
3269- 16- 10
DATE:
05-06-03
SHEET NO.
1 OF 1


PLAT OF SURVEY

UNIT 16-10
GENEVA NATIONAL CONDOMINIUM
NO. 16
LOCATED IN TOWN 2 NORTH, RANGE 17 EAST
WALWORTH COUNTY, WISCONSIN

GENEVA NATIONAL AVENUE
66' WIDE PRIVATE ROADWAY

BENCH MARK
RIM SANITARY
MANHOLE
ELEV.=1018.10'

SANITARY MH
1018.1

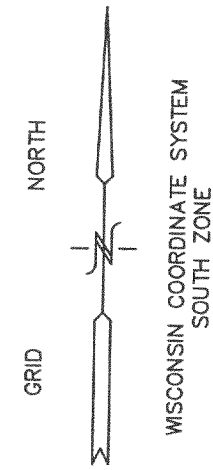

● = FOUND IRON REBAR STAKE
(xxx) = RECORDED AS

UNIT 16-09

UNIT 16-10
19,851 S.F.


NOTE: COPIES OF THIS MAP TO WHICH THE FOLLOWING CERTIFICATE WILL APPLY SHOW THE SURVEYOR'S ORIGINAL SEAL AND SIGNATURE IN RED INK. COPIES BY ANY OTHER MEANS MAY HAVE ALTERATIONS WHICH DO NOT REPRESENT THE SURVEYOR'S WORK PRODUCT.

I HEREBY CERTIFY THAT THE ABOVE DESCRIBED PROPERTY HAS BEEN SURVEYED UNDER MY DIRECTION AND THAT THE ABOVE MAP IS A TRUE REPRESENTATION THEREOF AND SHOWS THE SIZE AND LOCATION OF THE PROPERTY, ITS EXTERIOR BOUNDARIES, THE LOCATION OF ALL VISIBLE STRUCTURES, AND DIMENSIONS OF ALL PRINCIPLE BUILDINGS THEREON, BOUNDARY FENCES, APPARENT EASEMENTS, ROADWAYS, AND VISIBLE ENCROACHMENTS, IF ANY. THIS SURVEY IS MADE FOR THE USE OF THE PRESENT OWNERS OF THE PROPERTY, AND ALSO THOSE WHO PURCHASE, MORTGAGE, OR GUARANTEE THE TITLE THERETO WITHIN ONE YEAR FROM THE DATE HEREOF.

DATED: MAY 6, 2003

Peter S. Gordon
PETER S. GORDON

REVISED 08-13-2003
TO SHOW SIZE & LOCATION OF
FOUNDATION AS BUILT

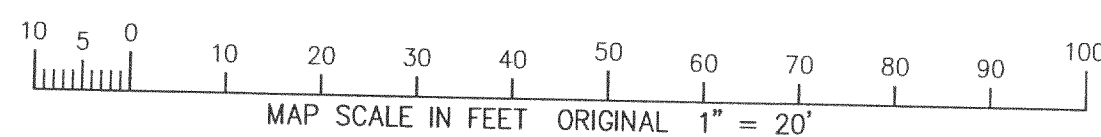

AUG 21 2003

KW

JGN 16-10

217-2632