


PLAT OF SURVEY

J.K. SURVEYING, INC.
 FORMERLY KOLB LAND CONSULTING
 N3705 WILLOW BEND LN. LAKE GENEVA, WI.
 (262)-248-3697

ORDERED BY: ROBERT FEDORKO
 913 N. CHURCH ST.
 APT. 102
 ELKHORN, WI 53121

DATE OF LAST REVISION: 5 / 15 / 2003
 DATE: 2-22-1999

DESCRIPTION: LOT 1 CERTIFIED SURVEY MAP NUMBER 3039
 A C.S.M. LOCATED IN THE SOUTHEAST 1/4
 AND THE SOUTHWEST 1/4 OF THE SOUTHEAST 1/4
 OF SECTION 27 AND IN THE NORTHEAST 1/4
 AND THE NORTHWEST 1/4 OF THE NORTHEAST
 1/4 OF SECTION 34 T 2 N, R 17 E WALWORTH
 COUNTY, WISCONSIN.

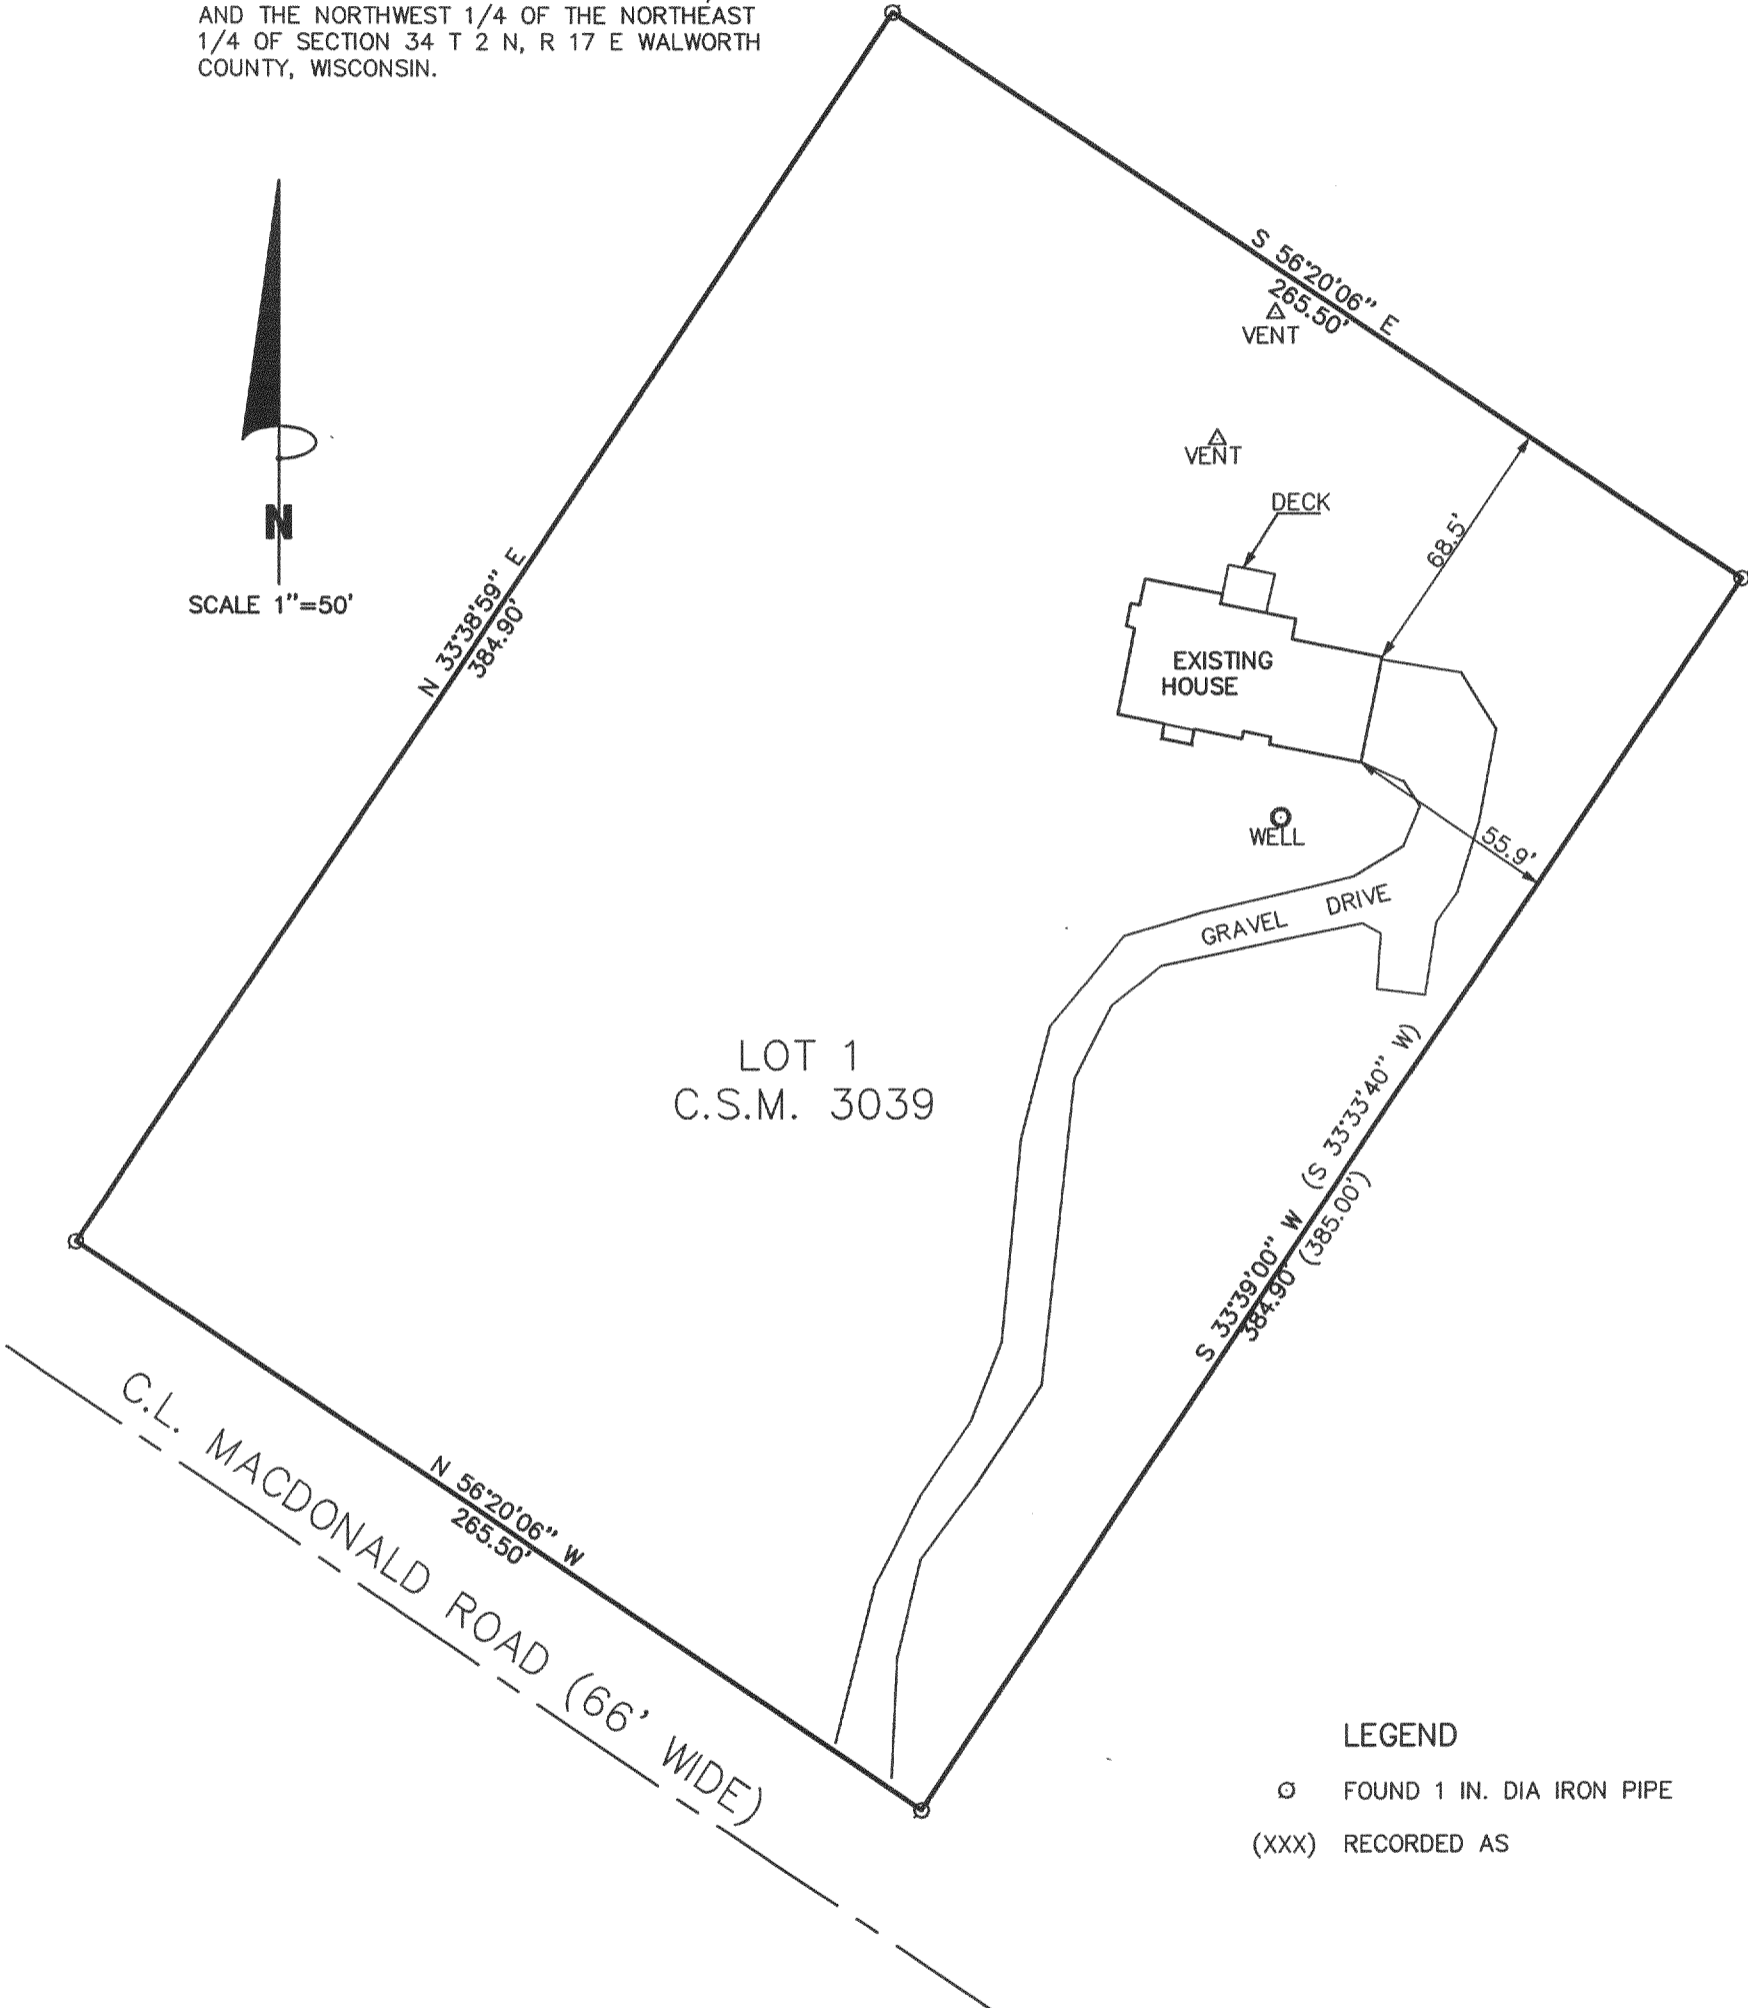


LEGEND
 ○ FOUND 1 IN. DIA IRON PIPE
 (XXX) RECORDED AS

THE ABOVE MAP IS A TRUE REPRESENTATION THEREOF AND SHOWS THE SIZE AND LOCATION OF ALL THE PROPERTY, EXTERIOR BOUNDARIES, THE LOCATION OF ALL VISIBLE BOUNDARY FENCES, APPARENT EASEMENTS, ROADWAYS AND VISIBLE ENCROACHMENTS, IF ANY

THIS SURVEY IS MADE FOR THE USE OF THE PRESENT OWNERS OF THE PROPERTY, AND ALSO THOSE WHO PURCHASE, MORTGAGE OR GUARANTEE TITLE THERETO WITHIN ONE (1) YEAR FROM DATE HERETO.

John P. Krott
 JOHN P. KROTT, R.L.S. 2258

OCT - 3 2003
 DRD

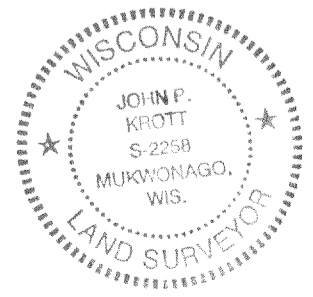

NOTE: THIS IS NOT A CERTIFIED COPY UNLESS SEAL IS IN RED.
 JOB NUMBER #98245 JG 30390001