

PREPARED FOR:
JIM AND KAREN ZGODA
1835 CONCORDIA LN.
SHAWMBER, IL. 60193

PLAT OF SURVEY


-OF-

J.K. SURVEYING INC.
N3705 WILLOWBEND LANE
LAKE GENEVA, WI, 53147
262-248-3697


LOTS 11043 THRU 11047, LAKE COMO BEACH, A SUBDIVISION LOCATED
IN T2N, R17E, WALWORTH COUNTY, WISCONSIN.

OCT - 3 2003

DEED

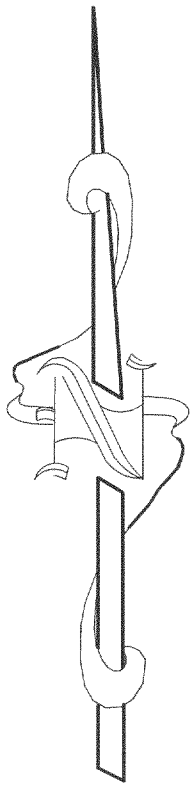

C.L. WILLOW ROAD (40' WIDE)

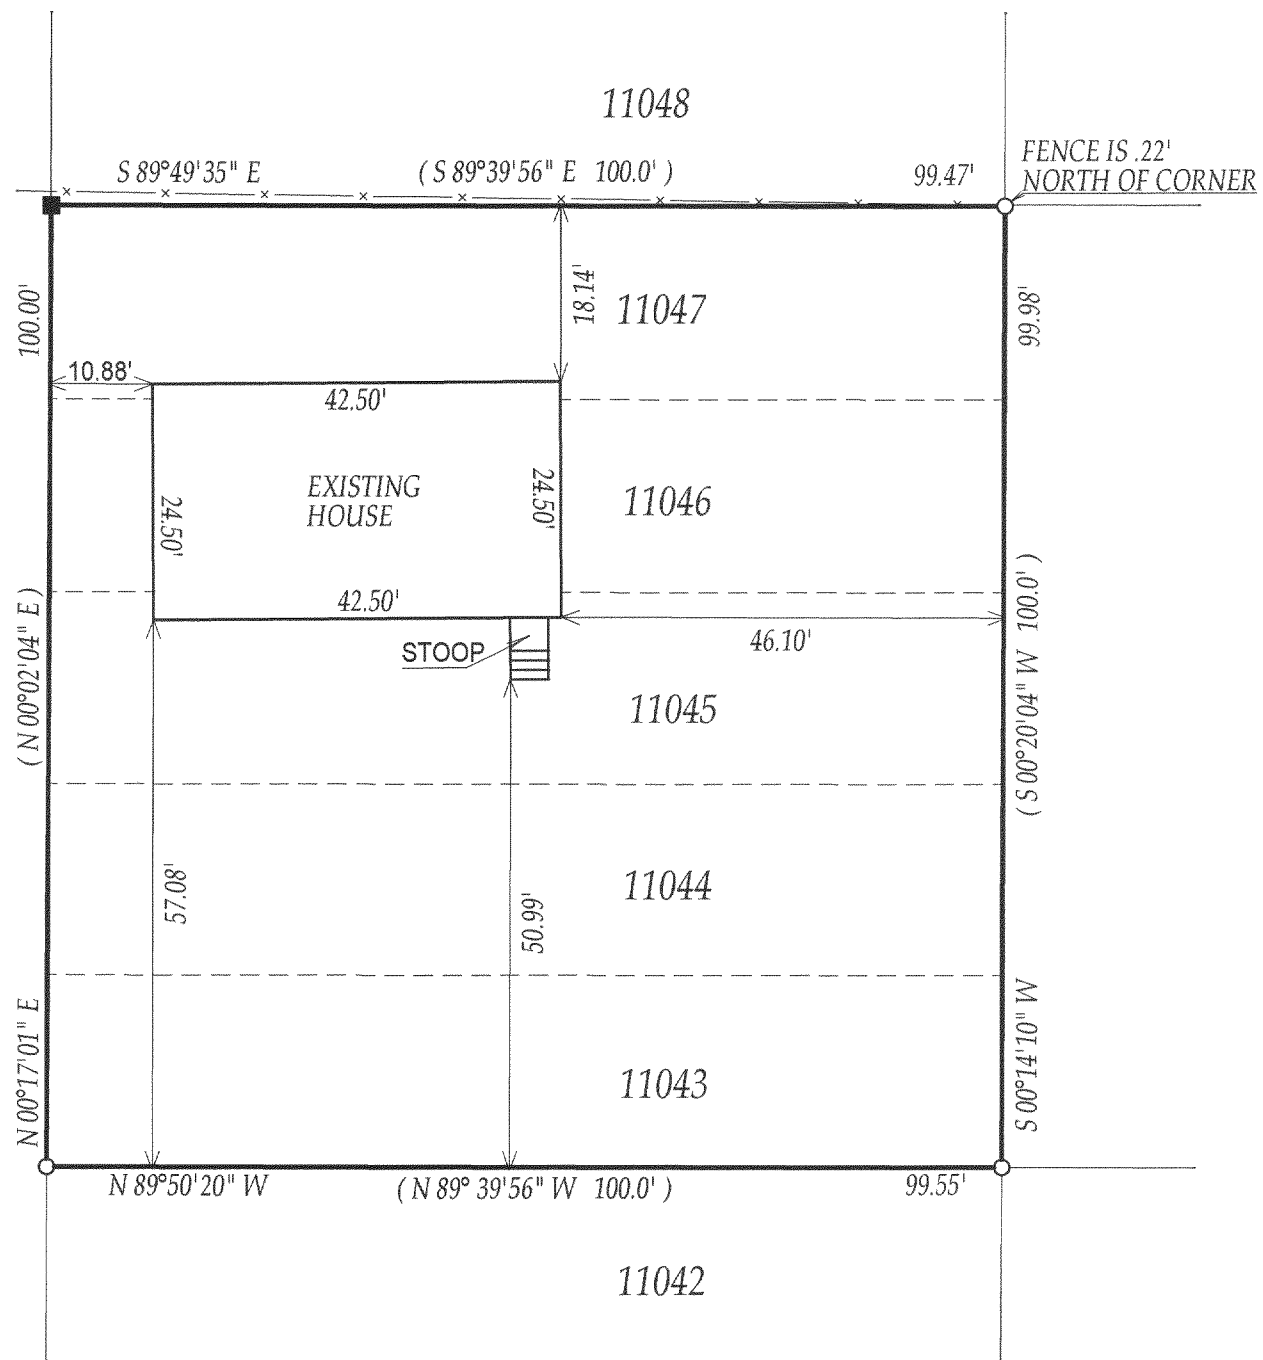

() = recorded as

□ = found iron bar

○ = found iron pipe

● = set iron pipe

■ = set iron bar

SCALE 1" = 20'

JOB # 03-349


TAX ID # JLCB 02407

COMPARE LEGAL DESCRIPTION ABOVE AND DRAWING WITH DEED. FOR BUILDING RESTRICTIONS AND EASEMENTS NOT SHOWN, REFER TO DEED, ABSTRACT SOURCES AND LOCAL MUNICIPAL CODES. NOTIFY THE SURVEYOR IMMEDIATELY OF ANY DISCREPANCY.

"I hereby certify that the above described property was surveyed under my supervision and that the above map is a true representation thereof and shows the size and location of all visible structures, apparent easements and encroachments if any."

This survey is made for the present owners of the property, and those who purchase, mortgage, or guarantee the title thereto, within one year from the date hereof.

DATED THE 2 ND, DAY OF JULY 2003

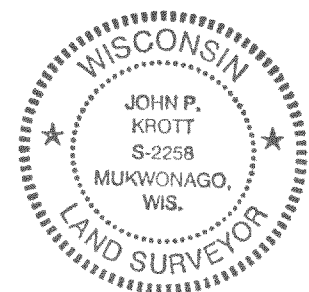

John P. Krott
JOHN KROTT S - 2258
Wisconsin Registered Land Surveyor
(original if signed in red)

217-2686