


# PLAT OF SURVEY

UNIT 15-29  
GENEVA NATIONAL CONDOMINIUM  
NO. 15  
LOCATED IN TOWN 2 NORTH, RANGE 17 EAST  
WALWORTH COUNTY, WISCONSIN

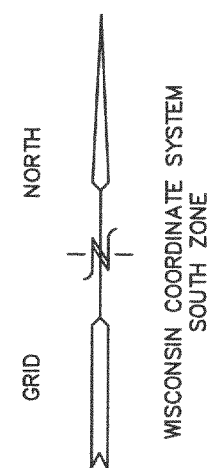

GOLF CLUB GROUNDS

UNIT 15-29  
21,106 S.F.

UNIT 15-28

UNIT 15-30

AS BUILT RESIDENCE

SWING SET  
7.8' SW OF  
LOT LINE

10' SIDE YARD


10' SIDE YARD

GENEVA NATIONAL AVENUE  
66' WIDE PRIVATE ROADWAY

SANI MH

BENCH MARK  
RIM SANITARY  
MANHOLE  
ELEV.=1060.08'

● = FOUND IRON REBAR STAKE  
(xxx) = RECORDED AS

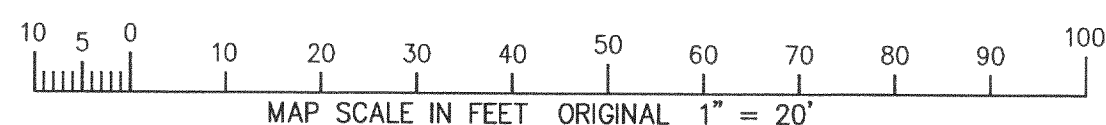

NOTE: COPIES OF THIS MAP TO WHICH THE FOLLOWING CERTIFICATE WILL APPLY SHOW THE SURVEYOR'S ORIGINAL SEAL AND SIGNATURE IN RED INK. COPIES BY ANY OTHER MEANS MAY HAVE ALTERATIONS WHICH DO NOT REPRESENT THE SURVEYOR'S WORK PRODUCT.

I HEREBY CERTIFY THAT THE ABOVE DESCRIBED PROPERTY HAS BEEN SURVEYED UNDER MY DIRECTION AND THAT THE ABOVE MAP IS A TRUE REPRESENTATION THEREOF AND SHOWS THE SIZE AND LOCATION OF THE PROPERTY AND ITS EXTERIOR BOUNDARIES. THIS SURVEY IS MADE FOR THE USE OF THE PRESENT OWNERS OF THE PROPERTY, AND ALSO THOSE WHO PURCHASE, MORTGAGE, OR GUARANTEE THE TITLE THERETO WITHIN ONE YEAR FROM THE DATE HEREOF.

DATED: 10-14-2002

REVISED 09-29-2003  
TO SHOW SIZE & LOCATION OF  
AS BUILT FOUNDATION

PETER S. GORDON R.L.S. 2101

WORK ORDERED BY  
JP MINCHILLO - MTM & SONS CONST.  
1055 BLACKBURN STREET  
GURNEE, IL 60031

FARRIS, HANSEN & ASSOCIATES, INC.  
Engineering, Architecture, Surveying  
7 Ridgway Court P.O. Box 437  
ELKHORN, WISCONSIN 53121  
Office: (262) 723-2098  
Fax: (262) 723-5886

REVISIONS  
06/13/2003  
TO SHOW  
TOPOGRAPHIC  
FEATURES

PROJECT NO.  
3269.15-29  
DATE:  
10/01/02  
SHEET NO.  
1 OF 1

J6N15-29

217-2714