



# PLAT OF SURVEY

UNIT 19-11  
GENEVA NATIONAL CONDOMINIUM  
NO. 19  
LOCATED IN TOWN 2 NORTH, RANGE 17 EAST  
WALWORTH COUNTY, WISCONSIN

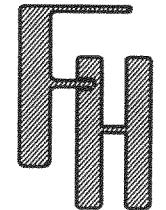

NORTH  
GRID  
WISCONSIN COORDINATE SYSTEM  
SOUTH ZONE

UNIT 19-10

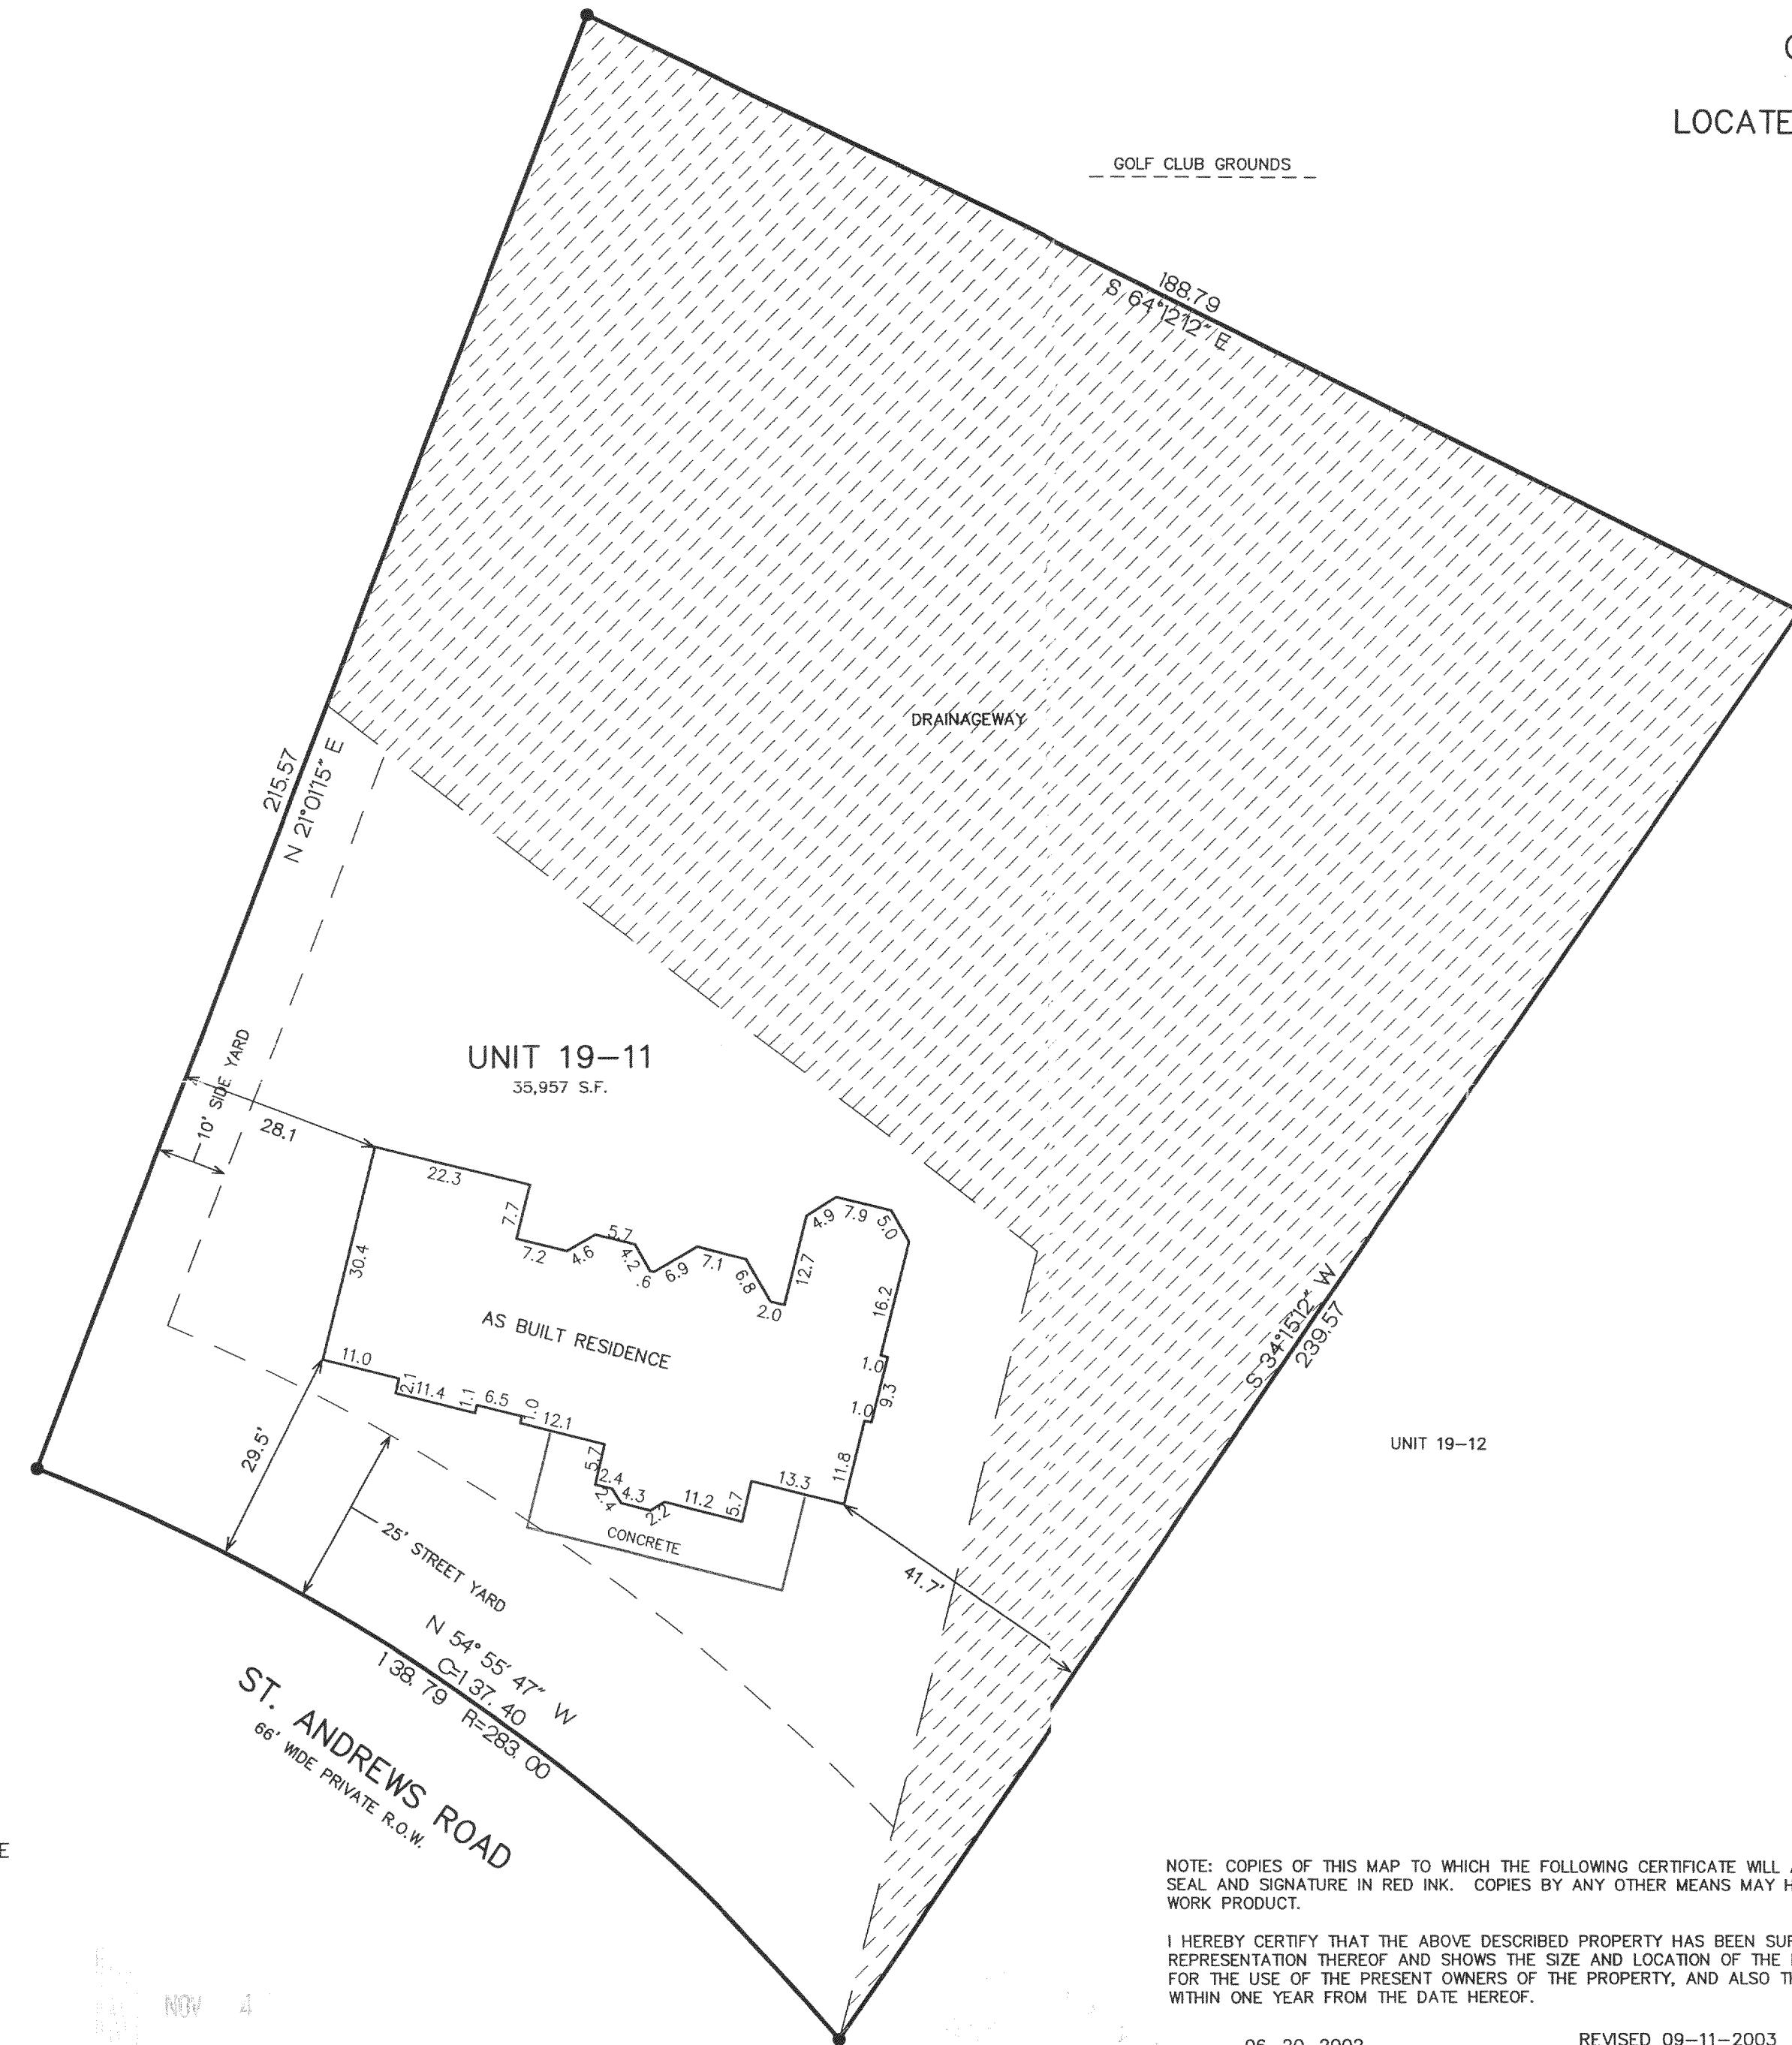

MAP SCALE IN FEET ORIGINAL 1" = 20'

WORK ORDERED BY  
CARL HOAG  
1062 PLANTATION COURT  
CRYSTAL LAKE, IL 60014

FARRIS, HANSEN & ASSOCIATES, INC.  
Engineering, Architecture, Surveying  
7 Ridgeway Court P.O. Box 437  
ELKHORN, WISCONSIN 53121  
Office: (414) 723-2098  
Fax: (414) 723-5886

REVISIONS

PROJECT NO.  
3269.19-11  
DATE:  
10-05-01  
SHEET NO.  
1 OF 1

J6N19-11

217-2717