

PLAT OF SURVEY

WORK ORDERED BY -
SANCTUARY HOMES
121 WOLF RUN SUITE 4
MUKWONAGO, WI. 53149

FARRIS, HANSEN & ASSOCIATES, INC.
ENGINEERING - ARCHITECTURE - SURVEYING
7 RIDGWAY COURT P.O. BOX 437
ELKHORN, WISCONSIN 53121
OFFICE: (262) 723-2098 FAX: (262) 723-5886

REVISIONS


PROJECT NO.
3269.15-07

DATE:
08-14-03

SHEET NO.
1 OF 1

PLAT OF SURVEY

UNIT 15-07
GENEVA NATIONAL CONDOMINIUM NO. 15
LOCATED IN TOWN 2 NORTH, RANGE 17 EAST,
WALWORTH COUNTY, WISCONSIN

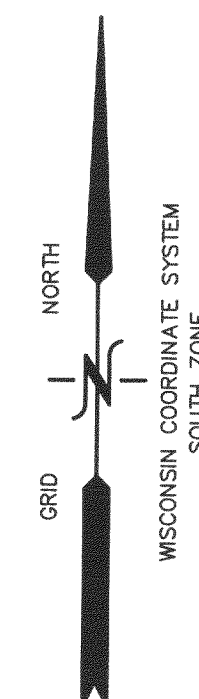

LEGEND

- = FOUND IRON REBAR STAKE
- ⚡ = SET IRON REBAR STAKE
- {XXX} = RECORDED AS

NOTE: COPIES OF THIS MAP TO WHICH THE FOLLOWING CERTIFICATE WILL APPLY SHOW THE SURVEYOR'S ORIGINAL SEAL AND SIGNATURE IN RED INK. COPIES BY ANY OTHER MEANS MAY HAVE ALTERATIONS WHICH DO NOT REPRESENT THE SURVEYOR'S WORK PRODUCT.

I HEREBY CERTIFY THAT THE ABOVE DESCRIBED PROPERTY HAS BEEN SURVEYED UNDER MY DIRECTION AND THAT THE ABOVE MAP IS A TRUE REPRESENTATION THEREOF AND SHOWS THE SIZE AND LOCATION OF THE PROPERTY AND ITS EXTERIOR BOUNDARIES. THIS SURVEY IS MADE FOR THE USE OF THE PRESENT OWNERS OF THE PROPERTY, AND ALSO THOSE WHO PURCHASE, MORTGAGE, OR GUARANTEE THE TITLE THERETO WITHIN ONE YEAR FROM THE DATE HEREOF.

DATED: AUGUST 15, 2003

REVISED 12-05-03
TO SHOW SIZE & LOCATION
OF FOUNDATION AS BUILT

PETER S. GORDON R.L.S. 2101

15-10

GOLF CLUB GROUNDS

15-03

15-08

UNIT 15-07

15-06


TOP FOUNDATION
1029.8

AS BUILT FOUNDATION

PRIVATE ROADWAY

SAN. LAT. (IE = 1012.2)

BENCH MARK
UPPER FLANGE BOLT
HYDRANT
EL. = 1020.95'

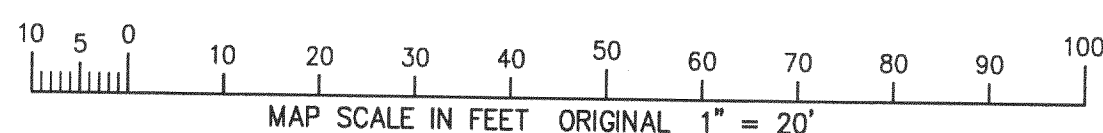

J6N15-07

217-2726