




# PLAT OF SURVEY

UNIT 15-29  
GENEVA NATIONAL CONDOMINIUM  
NO. 15  
LOCATED IN TOWN 2 NORTH, RANGE 17 EAST  
WALWORTH COUNTY, WISCONSIN

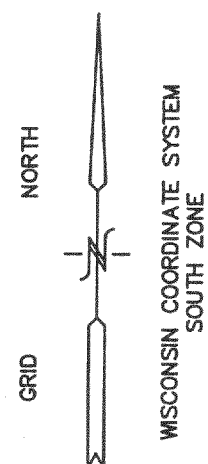

GOLF CLUB GROUNDS

UNIT 15-29  
21,106 S.F.

UNIT 15-28

UNIT 15-30

● = FOUND IRON REBAR STAKE  
(xxx) = RECORDED AS

10 5 0 10 20 30 40 50 60 70 80 90 100  
MAP SCALE IN FEET ORIGINAL 1" = 20'


EXTG. SANITARY  
MANHOLE

GENEVA NATIONAL AVENUE  
66' WIDE PRIVATE ROADWAY

EXTG. 8" SANITARY SEWER

EXTG. 12" WATERMAIN

BENCH MARK  
RIM SANITARY  
MANHOLE  
ELEV.=1060.08'

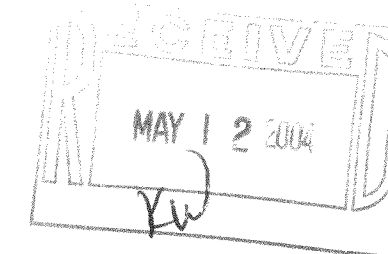

NOTE: COPIES OF THIS MAP TO WHICH THE FOLLOWING CERTIFICATE WILL APPLY SHOW THE SURVEYOR'S ORIGINAL SEAL AND SIGNATURE IN RED INK. COPIES BY ANY OTHER MEANS MAY HAVE ALTERATIONS WHICH DO NOT REPRESENT THE SURVEYOR'S WORK PRODUCT.

I HEREBY CERTIFY THAT THE ABOVE DESCRIBED PROPERTY HAS BEEN SURVEYED UNDER MY DIRECTION AND THAT THE ABOVE MAP IS A TRUE REPRESENTATION THEREOF AND SHOWS THE SIZE AND LOCATION OF THE PROPERTY, ITS EXTERIOR BOUNDARIES, THE LOCATION OF ALL VISIBLE STRUCTURES, AND DIMENSIONS OF ALL PRINCIPLE BUILDINGS THEREON, BOUNDARY FENCES, APPARENT EASEMENTS, ROADWAYS, AND VISIBLE ENCROACHMENTS, IF ANY. THIS SURVEY IS MADE FOR THE USE OF THE PRESENT OWNERS OF THE PROPERTY, AND ALSO THOSE WHO PURCHASE, MORTGAGE, OR GUARANTEE THE TITLE THERETO WITHIN ONE YEAR FROM THE DATE HEREOF.

DATED: 10-14-2002

PETER S. GORDON

REVISED 09-29-2003  
TO SHOW SIZE & LOCATION OF  
AS BUILT FOUNDATION

WORK ORDERED BY  
JP MINCHILLO - MTM & SONS CONST.  
1055 BLACKBURN STREET  
GURNEE, IL 60031

FARRIS, HANSEN & ASSOCIATES, INC.  
Engineering, Architecture, Surveying  
7 Ridgway Court P.O. Box 437  
ELKHORN, WISCONSIN 53121  
Office: (262) 723-2098  
Fax: (262) 723-5886

REVISIONS  
06/13/2003  
TO SHOW  
TOPOGRAPHIC  
FEATURES  
04/16/2004  
TO SHOW  
MISC. DETAIL

PROJECT NO.  
3269.15-29  
DATE:  
10/01/02  
SHEET NO.  
1 OF 1

JGN 1500029

217-2811