## PLAT OF SURVEY


J.K. SURVEYING, INC. FORMERLY KOLB LAND CONSULTING N3705 WILLOW BEND LANE LAKE GENEVA , WI (262) 248-3697

REVISED ON 5 / 19 / 2004 DATE: 10/13/1997

ORDERED BY: PAUL GAPP

N3213 SYCAMORE ROAD LAKE GENEVA, WI. 53147

DESCRIPTION: LOTS 2901,2902,2903,2931,2932, AND 2933 BLOCK 50 OF LAKE COMO BEACH, A SUBDIVISION LOCATED IN T 2 N , R 17 E, WALWORTH COUNTY, WISCONSIN.

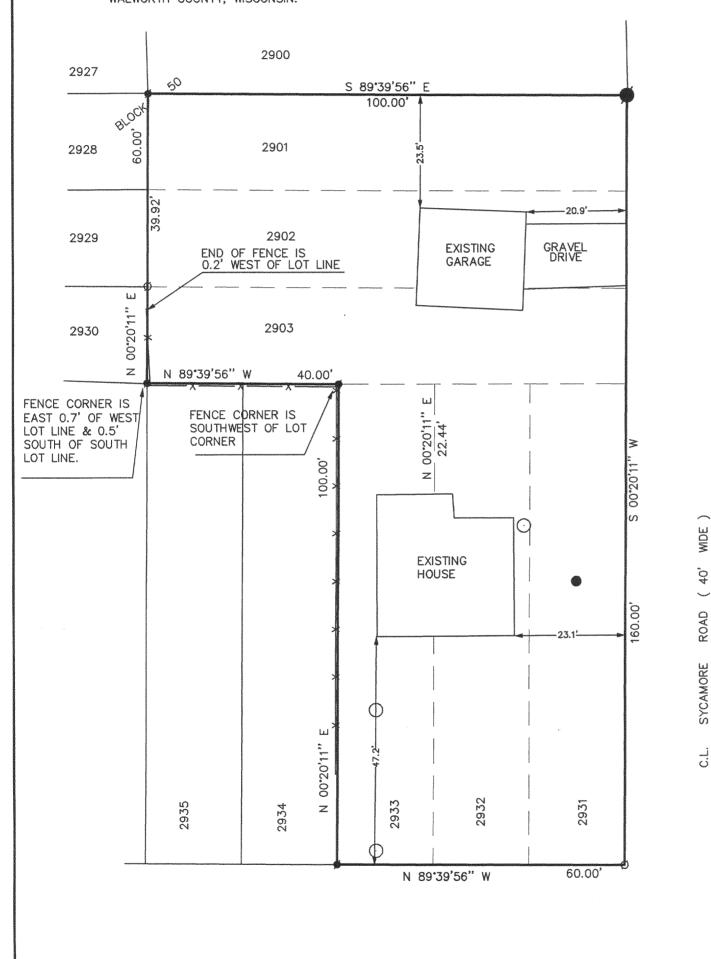



SCALE 1" = 20'

**LEGEND** 

- FOUND 1 IN. IRON PIPE
- SET 1 IN. IRON PIPE
- SET 2 IN. IRON PIPE
- MANHOLE
- WATER WELL

C.L LINCOLN DRIVE ( 50' WIDE )

THE ABOVE MAP IS A TRUE REPRESENTATION THEREOF AND SHOWS THE SIZE AND LOCATION OF ALL THE PROPERTY, EXTERIOR BOUNDARIES, THE LOCATION OF ALL VISIBLE BOUNDARY FENCES , APPARENT EASEMENTS , ROADWAYS AND VISIBLE ENCROACHMENTS, IF ANY

THIS SURVEY IS MADE FOR THE USE OF THE PRESENT OWNERS OF THE PROPERTY , AND ALSO THOSE WHO PURCHASE , MORTGAGE OR GURANTEE TITLE THERETO WITHIN ONE (1) YEAR FROM DATE HERETO.

JOHN P. KROTT, R.L.S. 2258





NOTE: THIS IS NOT A CERTIFIED COPY UNLESS SEAL IS IN RED.

JOB NUMBER 97094