
PREPARED FOR: BASSO BUILDERS 403 SKYLINE DR LAKE GENEVA, WI 53147

## PLAT OF SURVEY

J.K. SURVEYING INC. N3705 WILLOWBEND LANE LAKE GENEVA, WI, 53147 262-248-3697

- OF -

LOTS 10718 THRU 10722 ALL INCLUSIVE BLOCK 194 LAKE COMO BEACH A SUBDIVISION LOCATED IN T.2.N. , R.17.E. WALWORTH COUNTY, WISCONSIN.

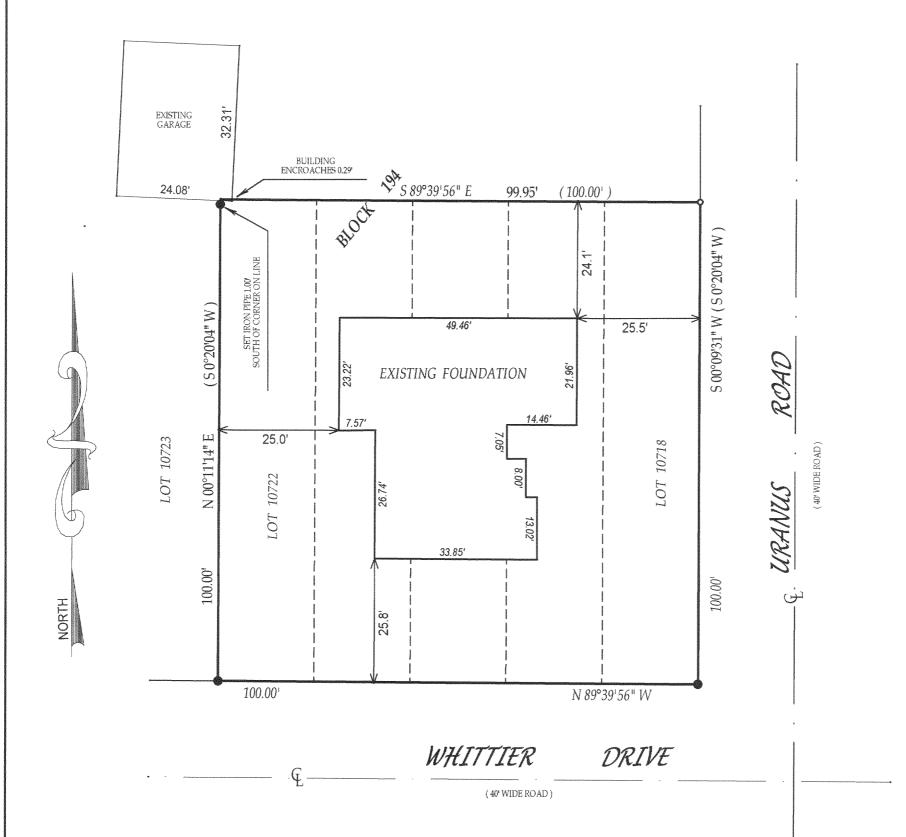

( )= recorded as

□ = found iron bar

= found iron pipe

= set iron pipe

= set iron bar

COMPARE LEGAL DESCRIPTION ABOVE AND DRAWING WITH DEED. FOR BUILDING RESTRICTIONS AND EASEMENTS NOT SHOWN, REFER TO DEED, ABSTRACT SOURCES AND LOCAL MUNICIPAL CODES. NOTIFY THE SURVEYOR IMMEDIATELY OF ANY DISCREPANCY.

SCALE 1" =20'

JOB #01-539BAB

"I hereby certify that I have surveyed the above described property and that the above map is a true representation thereof and shows the size and location of all visible structures, apparent easements and encroachments if any."

TAX ID # JLCB 2327

if any."
This survey is made for the present owners of the property, and those who purchase, mortgage, or guarantee the title thereto, within one year from the date hereof.



John Photo C. 2252

JOHN KROTT S - 2258
Wisconsin Registered Land Surveyor
( original if signed in red )
DATED THIS THE 1st OF MARCH, 2004

DATE OF LAST REVISION 04-16-04