


AMBIT LAND SURVEYING  
P. O. Box 42  
Bassett, WI. 53101

PLAT OF SURVEY  
OF

PHONE 262-537-4874  
FAX 262-537-4221

Lots 1012 thru 1014 and Lots 1032 thru 1036, all in Block 17 of LAKE COMO BEACH SUBDIVISION, being a subdivision located in Sections 21, 22, 27, 28 and 29, all in Township 2 North, Range 17 East of the 4th Principal Meridian, Walworth County, Wisconsin.

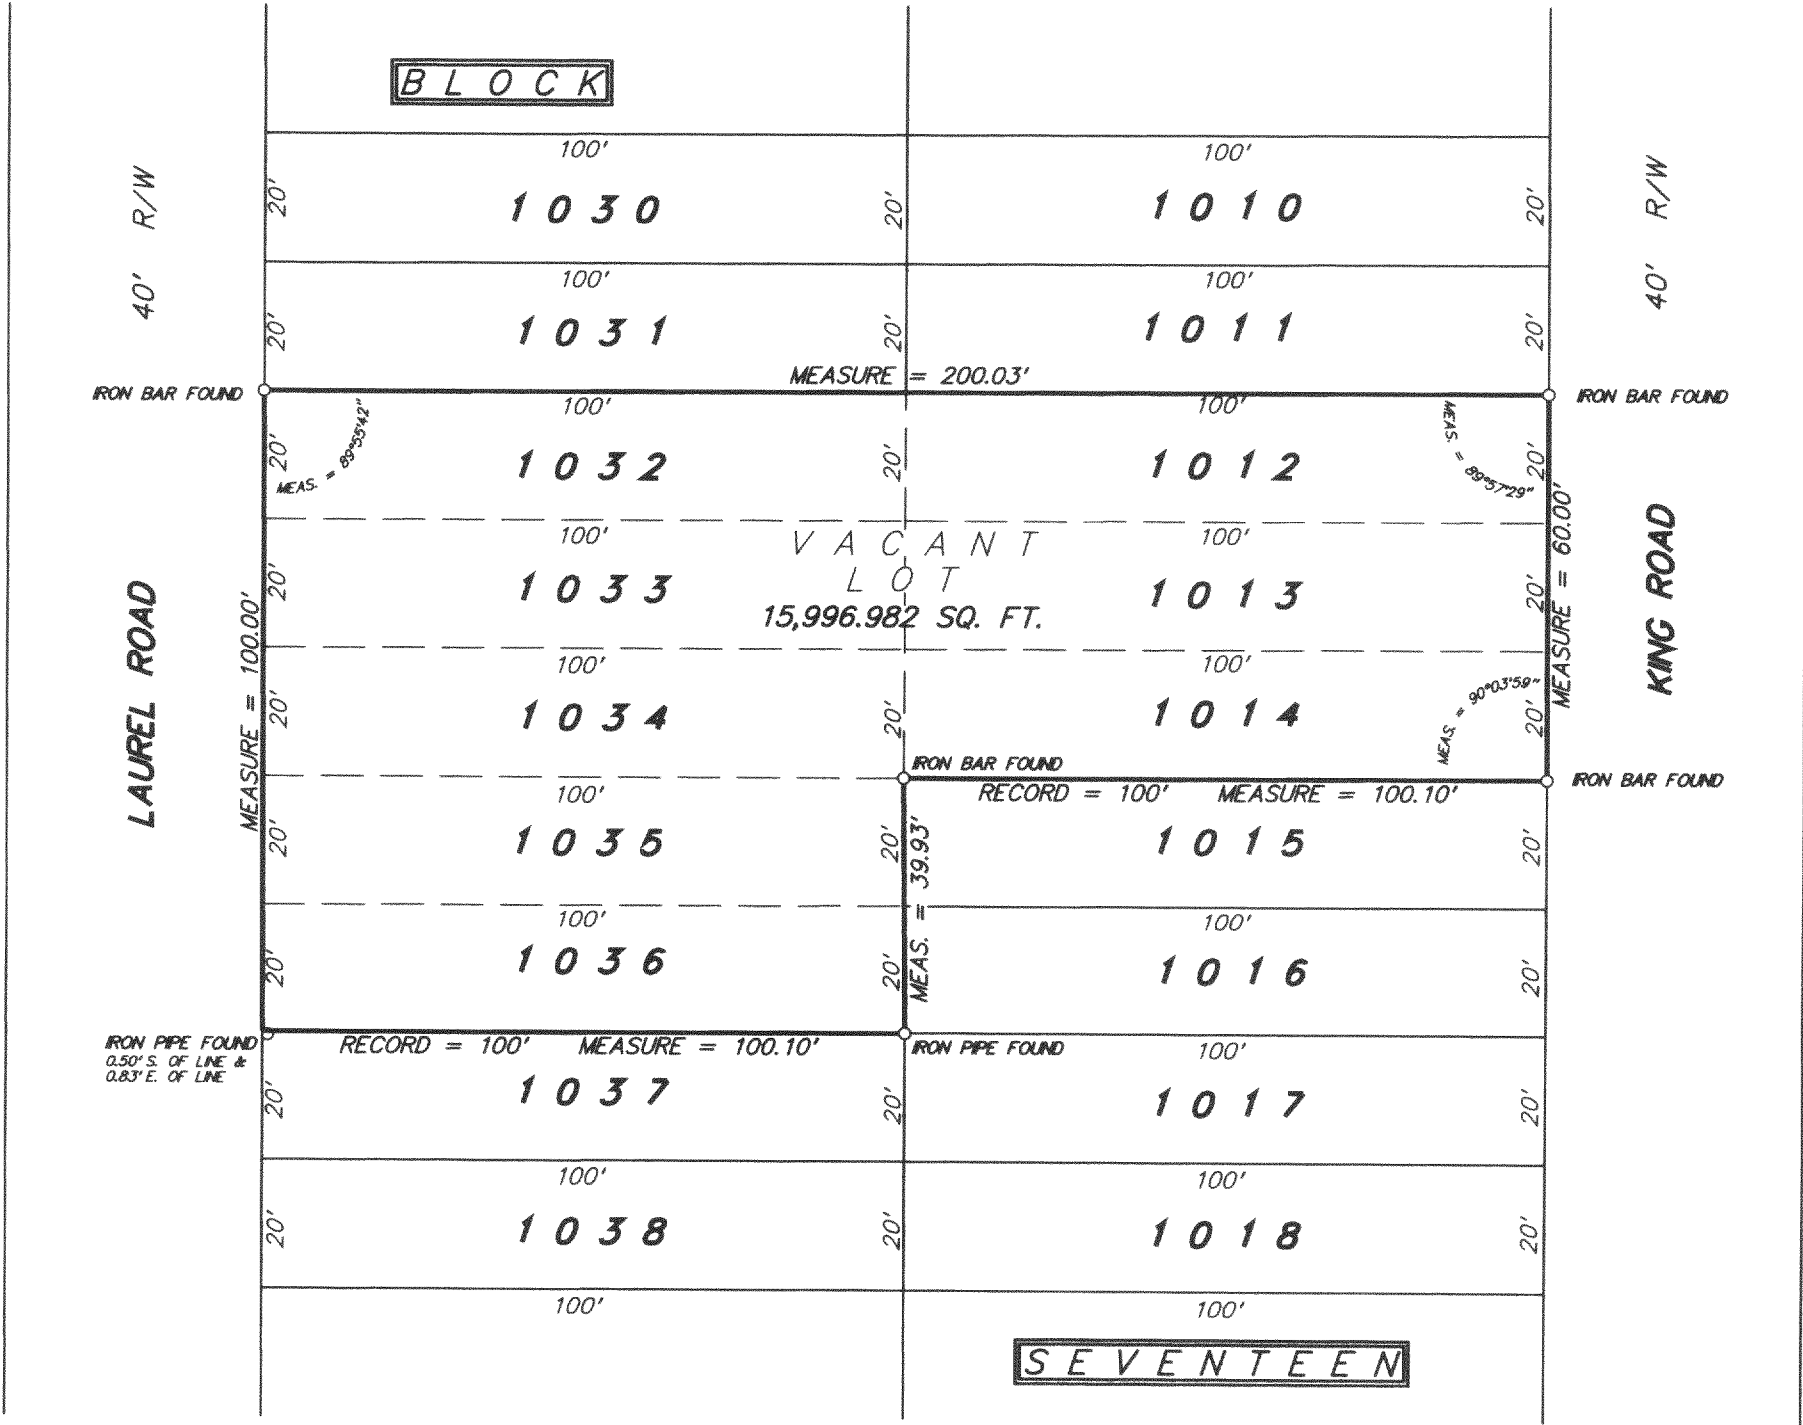

SCALE 1 inch = 30 feet  
ORDERED BY S. Venum  
JOB NO. 04020

I hereby certify that I have surveyed the above described property and the above plat is a true representation thereof and shows the size and location of the property, its exterior boundaries, the location and dimensions of all visible structures thereon, boundary fences, apparent easements and roadways and visible encroachments, if any.

This survey is made for the exclusive use of the present owners of the property, and also those who purchase, mortgage, or guarantee the title thereto within one year from the date hereof.

Dated at Bassett, Wisconsin this \_\_\_\_\_ day of \_\_\_\_\_ 2004.

Mark A. Bolender  
Wisconsin Registered Land Surveyor S - 1784

