PREPARED FOR: ALLEN SEARLES N3040 DANDELION RD. LAKE GENEVA, WI 53147

PLAT OF SURVEY


J.K. SURVEYING INC. N3705 WILLOWBEND LANE LAKE GENEVA, WI, 53147 262-248-3697

- OF -

LOTS 11998 THRU 12002 BLOCK 214 OF LAKE COMO BEACH SUBDIVISION; LOCATED IN TOWN 2 NORTH, RANGE 17 EAST, WALWORTH COUNTY, WISCONSIN

C.L. HEMLOCK ROAD

(40' WIDE)

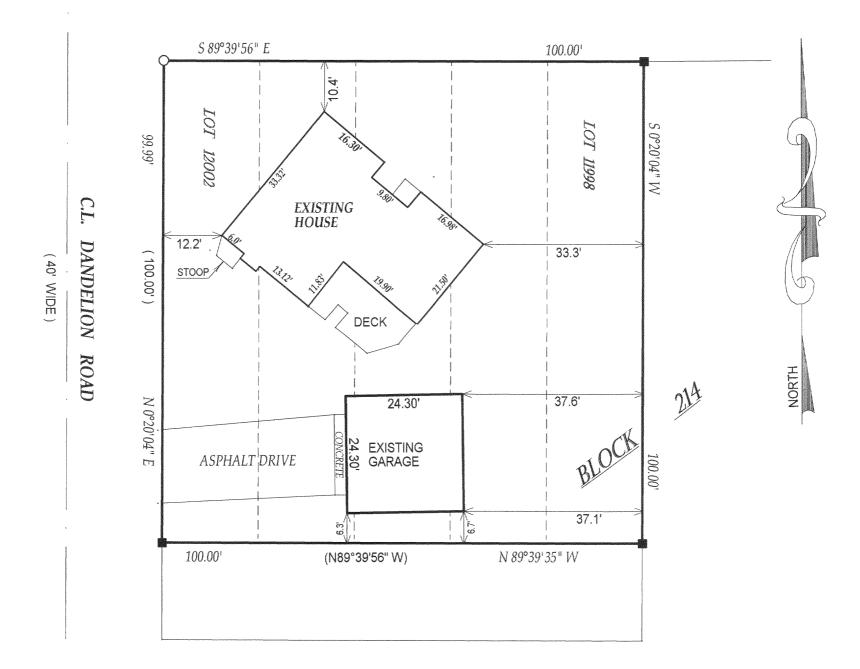

()= recorded as

 \Box = found iron bar

= found iron pipe

= set iron pipe

= set iron bar

SCALE 1" = 20'

JOB # 05-038

TAX ID #JLCB-2611




COMPARE LEGAL DESCRIPTION ABOVE AND DRAWING WITH DEED. FOR BUILDING RESTRICTIONS AND EASEMENTS NOT SHOWN, REFER TO DEED, ABSTRACT SOURCES AND LOCAL MUNICIPAL CODES. NOTIFY THE SURVEYOR IMMEDIATELY OF ANY DISCREPANCY.

"I hereby certify that I have surveyed the above described property and that the above map is a true representation thereof and shows the size and location of all visible structures, apparent easements and encroachments if any."

This survey is made for the present owners of the property, and those who purchase, mortgage, or guarantee the title thereto, within one year from the date hereof.

DATED THIS 14th, DAY OF FEBRUARY, 2005

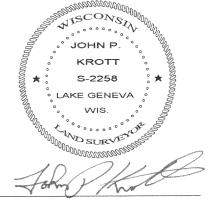

JOHN KROTT S - 2258 Wisconsin Registered Land Surveyor (original if signed in red)