


**HAROLD H. KOLB**  
REGISTERED PROFESSIONAL LAND SURVEYOR  
LAKE GENEVA, WISCONSIN

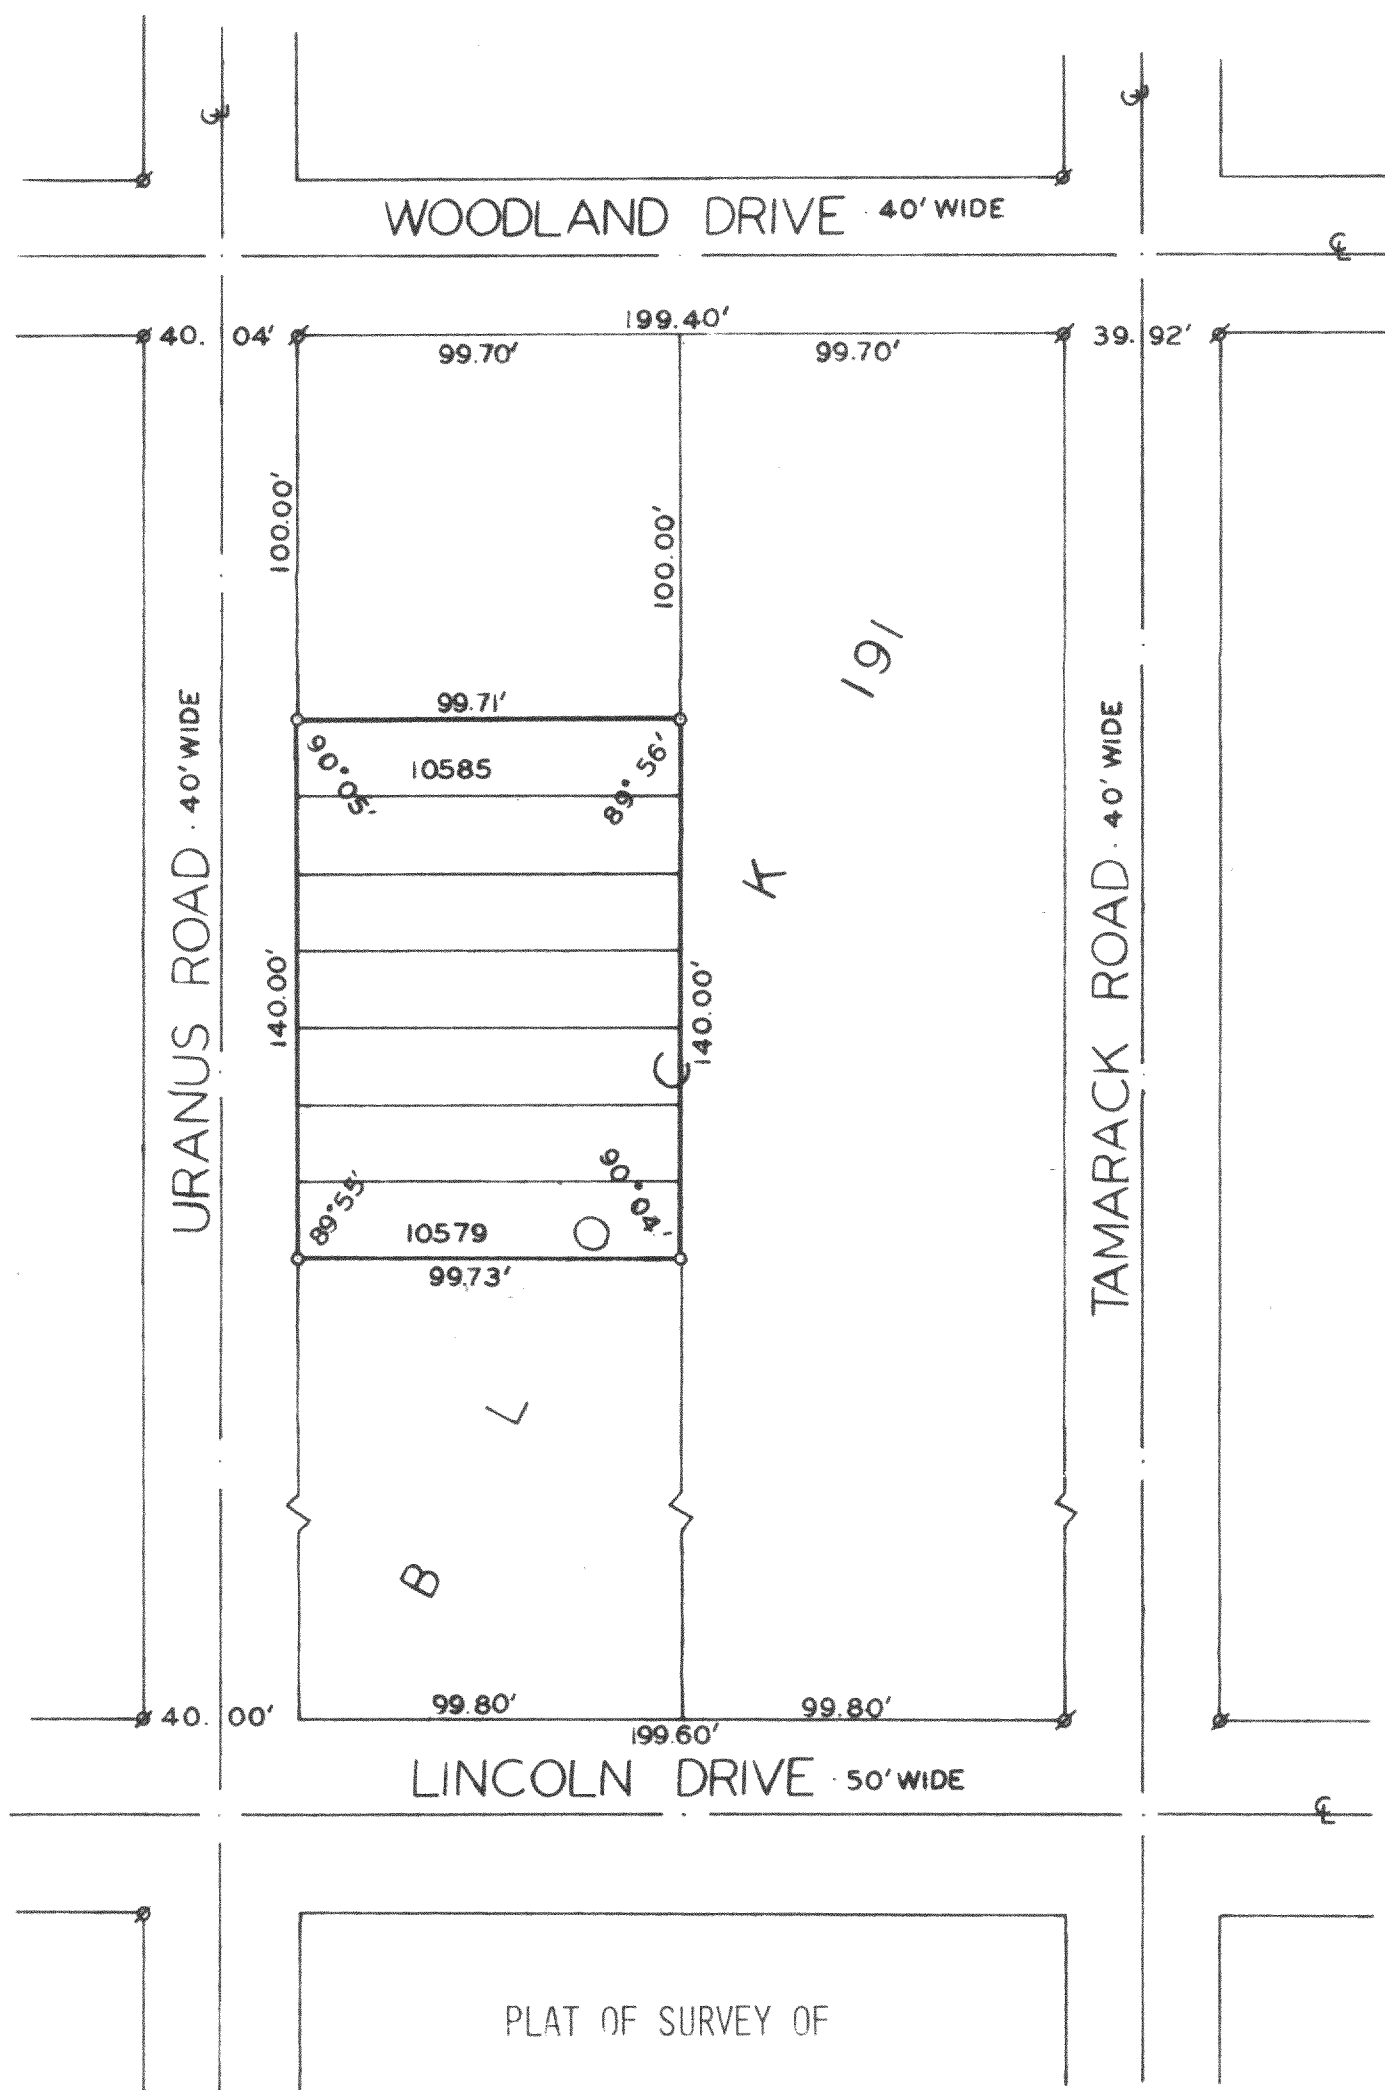


PLAT OF SURVEY OF  
LOTS 10579-10585, BLOCK 191, LAKE COMO  
BEACH SUBDIVISION, WALWORTH COUNTY,  
WISCONSIN.

**N**  
SCALE · 1" = 50'

**LEGEND**

- φ — IRON PIPE FOUND
- — IRON PIPE PLACED
- — CONCRETE MONUMENT
- x — SPIKE

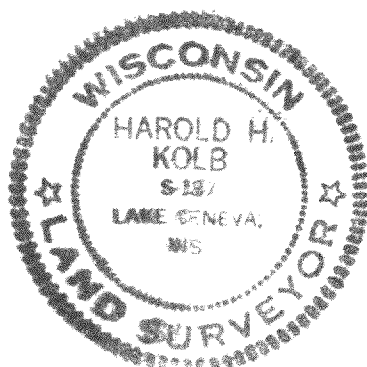

ORDERED BY: PAUL WURTZ & ASSOCIATES, INC.  
LAKE GENEVA, WI 53147

FOR: PAUL RILL

I, HAROLD H. KOLB, DO HEREBY CERTIFY THAT I HAVE  
SURVEYED THE PROPERTY HEREON DESCRIBED ACCORDING  
TO THE OFFICIAL RECORDS. AND THAT THE PLAT HEREON  
IS A CORRECT REPRESENTATION OF THE LOT LINES.

*Harold H. Kolb*

HAROLD H. KOLB  
WISCONSIN REGISTERED LAND SURVEYOR, S-187

DATE May 23, 1978

42477

VD. 225 PAGE 853

A F F I D A V I T

STATE OF WISCONSIN )  
COUNTY OF WALWORTH ) SS

I, Harold H. Kolb, Registered Land Surveyor No. S-187, hereby certify:

That I have done a Survey of Lots 35 through 38 and Lots 83 through 86 of the Gummow Addition, as Recorded in Volume 8, Page 41 of Plats.

That a discrepancy of 25 feet was found between the distances as shown on said Recorded Plat, and the actual distances as measured on the ground.

That the ground measurements were 25 feet less than the distances shown on the Recorded Plat.

That the discrepancy would result in the loss of 2 lots, or the reduction in the width of the Recorded Cross Street by 25 feet.

That I believe the intent of the original subdivision was to create 106 lots; and, therefore, have indicated that the error is most likely in Cross Street, making said Cross Street 25 feet in width, rather than the 50 feet in width as shown on the Recorded Plat.

That the above is true and correct to the best of my knowledge and belief.

Harold H. Kolb  
HAROLD H. KOLB  
Wis. Registered Land Surveyor, S-187

In Presence Of:

Douglas A. Kolb

Robert Baumwald

Subscribed and sworn to before me  
this 15 day of December, 1978.

Feb 2 1979 ✓

Janet Kerkham

Notary Public, Walworth County, Wisconsin

RECORDED IN VOL 225  
PAGE 853

My Commission expires: March 18, 1979 DEC 27 PM 3 04

LOIS H. KEEFERHART  
REG. OF DEEDS  
WALWORTH COUNTY, WIS.

H Kolb

2. J. J. J.

217-305