


217-3068

# PLAT OF SURVEY AS-BUILT MAPPING

UNIT 15-16  
GENEVA NATIONAL CONDOMINIUM  
NO. 15  
LOCATED IN TOWN 2 NORTH, RANGE 17 EAST  
WALWORTH COUNTY, WISCONSIN

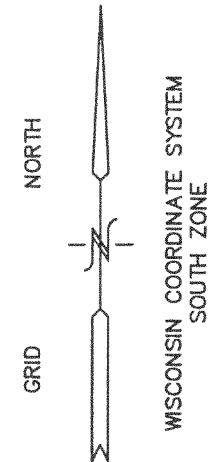

● = FOUND IRON REBAR STAKE  
(xxx) = RECORDED AS

UNIT 15-17

GOLF CLUB GROUNDS

UNIT 15-16  
21,849 S.F.

UNIT 15-15

UTIL BOX  
TIC BOX  
ELEC BOX

EXISTING  
SANITARY  
MANHOLE

BENCH MARK  
NORTH UPPER  
FLANG BOLT  
ON HYDRANT  
ELEV.=1049.98'

GULLANE COURT  
66' WIDE PRIVATE R.O.W.

ELECTRIC POST FOR  
UNDERGROUND UTILITY

NOTE: COPIES OF THIS MAP TO WHICH THE FOLLOWING CERTIFICATE  
WILL APPLY SHOW THE SURVEYOR'S ORIGINAL SEAL AND SIGNATURE  
IN RED INK. COPIES BY ANY OTHER MEANS MAY HAVE ALTERATIONS  
WHICH DO NOT REPRESENT THE SURVEYOR'S WORK PRODUCT.

I HEREBY CERTIFY THAT THE ABOVE DESCRIBED PROPERTY HAS BEEN  
SURVEYED UNDER MY DIRECTION AND THAT THE ABOVE MAP IS A TRUE  
REPRESENTATION THEREOF AND SHOWS THE SIZE AND LOCATION OF  
THE PROPERTY AND ITS EXTERIOR BOUNDARIES. THIS SURVEY IS  
MADE FOR THE USE OF THE PRESENT OWNERS OF THE PROPERTY, AND  
ALSO THOSE WHO PURCHASE, MORTGAGE, OR GUARANTEE THE TITLE  
THERE TO WITHIN ONE YEAR FROM THE DATE HEREOF.

DATED: AUGUST 20, 2004

PETER S. GORDON R.L.S. 2101

WORK ORDERED BY  
JOHN MAKI - J. MAKI CONST.  
460 NORTH MAIN STREET  
ANTIOCH, IL 60002

FARRIS, HANSEN & ASSOCIATES, INC.  
Engineering, Architecture, Surveying  
7 Ridgeway Court P.O. Box 437  
ELKHORN, WISCONSIN 53121  
Office: (262) 723-2098  
Fax: (262) 723-5886

REVISIONS  
09/15/2004  
SITE, GRADING,  
DRAINAGE, &  
EROSION  
CONTROL PLAN  
07/28/2005  
TO SHOW SIZE  
AND LOCATION  
OF AS-BUILT  
RESIDENCE

PROJECT NO.  
3269.15.16  
DATE:  
08/20/04  
SHEET NO.  
1 OF 1

310150016

