



PLAT OF SURVEY

UNIT 16-12
GENEVA NATIONAL CONDOMINIUM
NO. 16
LOCATED IN TOWN 2 NORTH, RANGE 17 EAST
WALWORTH COUNTY, WISCONSIN

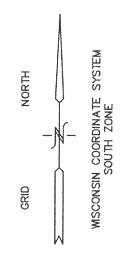

= FOUND IRON REBAR STAKE = SET IRON REBAR STAKE (XXX) = RECORDED AS

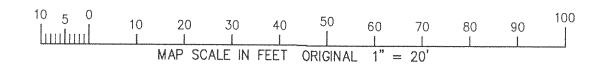

NOTE: COPIES OF THIS MAP TO WHICH THE FOLLOWING CERTIFICATE WILL APPLY SHOW SURVEYOR'S ORIGINAL SEAL AND SIGNATURE IN RED INK. COPIES BY ANY OTHER MEANS MAY HAVE ALTERATIONS WHICH DO NOT REPRESENT THE SURVEYOR'S WORK PRODUCT.

I HEREBY CERTIFY THAT THE ABOVE DESCRIBED PROPERTY HAS BEEN SURVEYED UNDER MY DIRECTION AND THAT THE ABOVE MAP IS A TRUE REPRESENTATION THEREOF AND SHOWS THE SIZE AND LOCATION OF THE PROPERTY, ITS EXTERIOR BOUNDARIES, THE LOCATION OF ALL VISIBLE STRUCTURES, AND DIMENSIONS OF ALL PRINCIPLE BUILDINGS THEREON, BOUNDARY FENCES, APPARENT EASEMENTS, ROADWAYS, AND VISIBLE ENCROACHMENTS, IF ANY. THIS SURVEY IS MADE FOR THE USE OF THE PRESENT OWNERS OF THE PROPERTY, AND ALSO THOSE WHO PURCHASE, MORTGAGE, OR GUARANTEE THE TITLE THERETO WITHIN ONE YEAR FROM THE DATE HEREOF.

DATED: JULY 27, 2005

RADER CUP

ROND

UNIT 16-12

15,987 S.F.

FOUND REBAR DISTURBED RESET TO RECORD POSITION

PETER S. GORDON R.L.S. 2101

WORK ORDERED BY KEEFE REAL ESTATE 751 GENEVA PARKWAY LAKE GENEVA. WI. 53

HANSEN & ASSOCIATES, INC.
ering, Architecture, Surveying
ildgway Court P.O. Box 437
LKHORN, WISCONSIN 53121

REVISIONS

PROJECT NO.
3269.16-12
DATE:
07-27-05
SHEET NO.

1 OF 1

288 23