
## PLAT OF SURVEY -OF-

LOT 62 OF CONSUMER'S COMPANY SUBDIVISION OF LAKE COMO, BEING A SUBDIVISION OF PARTS OF SECTIONS 28, 32 AND 33, ALL IN TOWNSHIP 2 NORTH, RANGE 17 EAST OF THE FOURTH PRINCIPAL MERIDIAN, A PLAT OF WHICH WAS RECORDED IN THE OFFICE OF THE REGISTER OF DEEDS OF WALWORTH COUNTY, WISCONSIN. SAID LAND BEING IN THE TOWN OF GENEVA, COUNTY OF WALWORTH AND STATE OF WISCONSIN.

SURVEY FOR: JOHN NORTON

SURVEY ADDRESS: W4036 SOUTH SHORE DRIVE




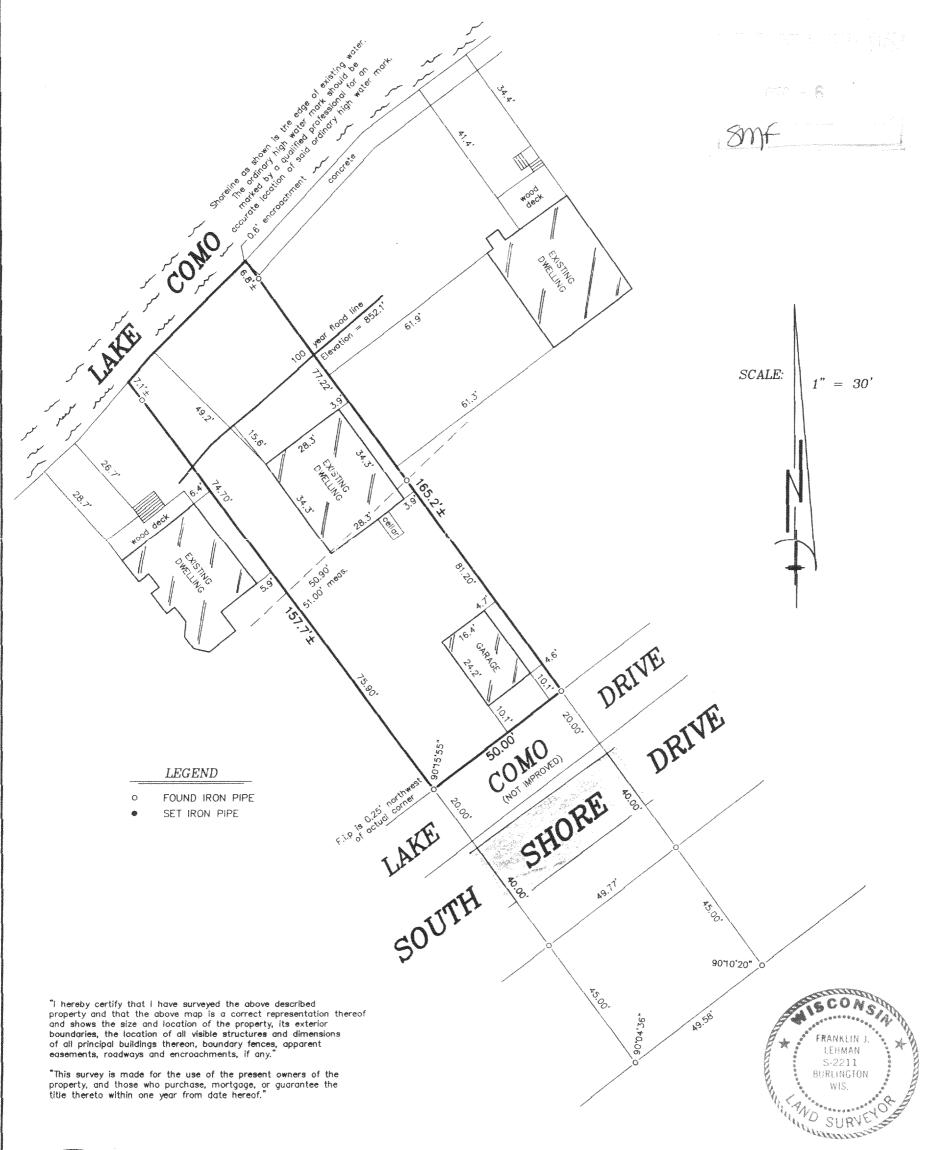

B.W. SURVEYING, INC.

LAND SURVEYS
MAPPING AND PLANNING
412 N. PINE STREET
BURLINGTON, WI 53105
(262)-767-0225

THIS IS NOT AN ORIGINAL PRINT UNLESS THIS SEAL IS RED.

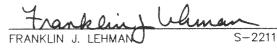

REVISED: OCTOBER 17, 2005 SEPTEMBER 28, 2005

7040 JOB NUMBER

JCON-34