

# PLAT OF SURVEY

UNIT 3-57  
GENEVA NATIONAL CONDOMINIUM  
NO. 3

LOCATED IN TOWN 2 NORTH, RANGE 17 EAST  
WALWORTH COUNTY, WISCONSIN

UNIT 3-56

GENEVA NATIONAL CONDOMINIUM NO. 4

- LEGEND**
- = FOUND IRON REBAR STAKE
  - = SET STEEL PIN W/CAP
  - (xxx) = RECORDED AS

SARATOGA LANE  
66' PRIVATE ROADWAY

ZURICH DRIVE


NOTE: COPIES OF THIS MAP TO WHICH THE FOLLOWING CERTIFICATE WILL APPLY SHOW SURVEYOR'S ORIGINAL SEAL AND SIGNATURE IN RED INK. COPIES BY ANY OTHER MEANS MAY HAVE ALTERATIONS WHICH DO NOT REPRESENT THE SURVEYOR'S WORK PRODUCT.

I HEREBY CERTIFY THAT THE ABOVE DESCRIBED PROPERTY HAS BEEN SURVEYED UNDER MY DIRECTION AND THAT THE ABOVE MAP IS A TRUE REPRESENTATION THEREOF AND SHOWS THE SIZE AND LOCATION OF THE PROPERTY, ITS EXTERIOR BOUNDARIES, THE LOCATION OF ALL VISIBLE STRUCTURES, AND DIMENSIONS OF ALL PRINCIPLE BUILDINGS THEREON, BOUNDARY FENCES, APPARENT EASEMENTS, ROADWAYS, AND VISIBLE ENCROACHMENTS, IF ANY. THIS SURVEY IS MADE FOR THE USE OF THE PRESENT OWNERS OF THE PROPERTY, AND ALSO THOSE WHO PURCHASE, MORTGAGE, OR GUARANTEE THE TITLE THERETO WITHIN ONE YEAR FROM THE DATE HEREOF.

DATED: JUNE 19, 2006

PETER S. GORDON R.L.S. 2101

MAP SCALE IN FEET ORIGINAL 1" = 20'

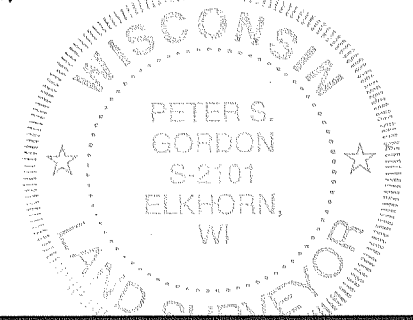

WORK ORDERED BY -  
MICHAEL RAYMOND CUSTOM HOMES  
MICHAEL-DEAN CHORNEYKO  
2000 WEST MAIN STREET, SUITE E  
ST. CHARLES, IL 60174

FARRIS, HANSEN & ASSOCIATES, INC.  
Engineering, Architecture, Surveying  
7 Ridgway Court P.O. Box 437  
ELKHORN, WISCONSIN 53121  
Office: (414) 723-2098  
Fax: (414) 723-5886

REVISIONS  
05/06/2005  
REV. GRADING  
AT EAST END  
RESIDENCE  
08/19/2005  
TO SHOW SIZE  
AND LOCATION  
OF AS-BUILT  
FOUNDATION  
06/15/2006  
ADD ADDITIONAL  
INFORMATION  
TO TITLE SPECS

PROJECT NO.  
3269.3-57  
DATE:  
7/10/98  
SHEET NO.  
1 OF 1

217-3264