
PREPARED FOR: DIANE COCROFT KEEFE REALTY 751 GENEVA PARKWAY LAKE GENEVA WI 53147


PLAT OF SURVEY

OF -

PATHFINDER SURVEYING INC. W2888 KRUEGER RD. UNIT "D" LAKE GENEVA WI. 53147 (262) 248-3697


LOTS 4296 THRU 4300 BLOCK 73 OF LAKE COMO BEACH SUBDIVISION; LOCATED IN TOWN 2 NORTH, RANGE 17 EAST, WALWORTH COUNTY, WISCONSIN

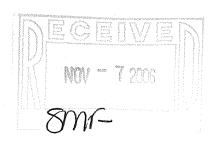

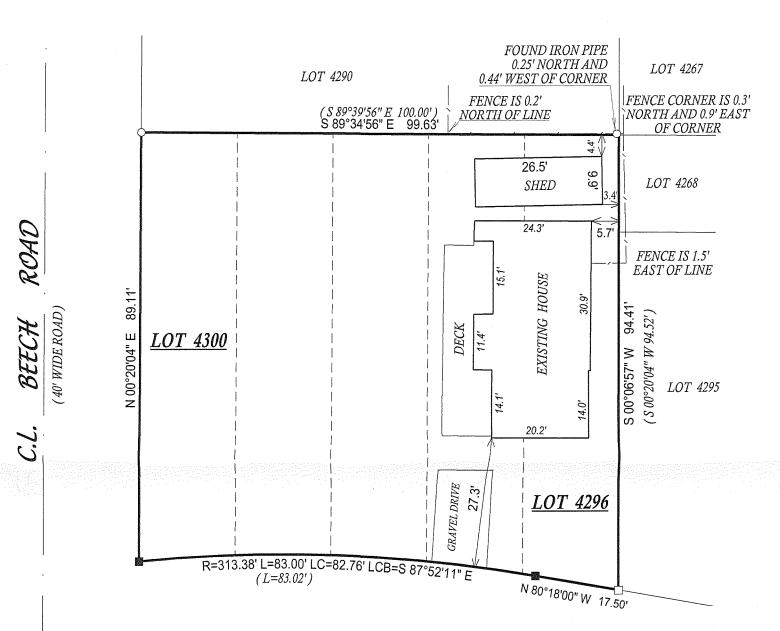

C.L. LAKE SHORE DRIVE

(50' WIDE ROAD)

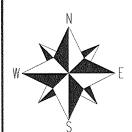

()= recorded as

 \Box = found iron bar

= found iron pipe

= set iron pipe

= set iron bar

SCALE 1" = 20'

JOB # 06-386

TAX ID # JLCB00838

COMPARE LEGAL DESCRIPTION ABOVE AND DRAWING WITH DEED. FOR BUILDING RESTRICTIONS AND EASEMENTS NOT SHOWN, REFER TO DEED, ABSTRACT SOURCES AND LOCAL MUNICIPAL CODES. NOTIFY THE SURVEYOR IMMEDIATELY OF ANY DISCREPANCY.

"I hereby certify that I have surveyed the above described property and that the above map, to the best of my knowledge and belief, is a true representation thereof and shows the size and location of all visible structures, apparent easements and encroachments fany."

This survey is made for the present owners of the property, and those who purchase, mortgage, or guarentee the title thereto, within one year from the date hereof.



JOHN KROTT S-2258

JOHN KROTT S - 2258
Wisconsin Registered Land Surveyor
(original if signed in red)
DATED THIS THE 31st DAY OF JULY 2006.

217-3316