
Plat of Survey Lots 6,940 Through 6,944 of Block 119 of Lake Como Beach,

a subdivision located in the Northwest 1/4 of Section 28, Town 2 North, Range 17 East, Town of Geneva, Walworth County, Wisconsin

Surveyed for: Jim Pody

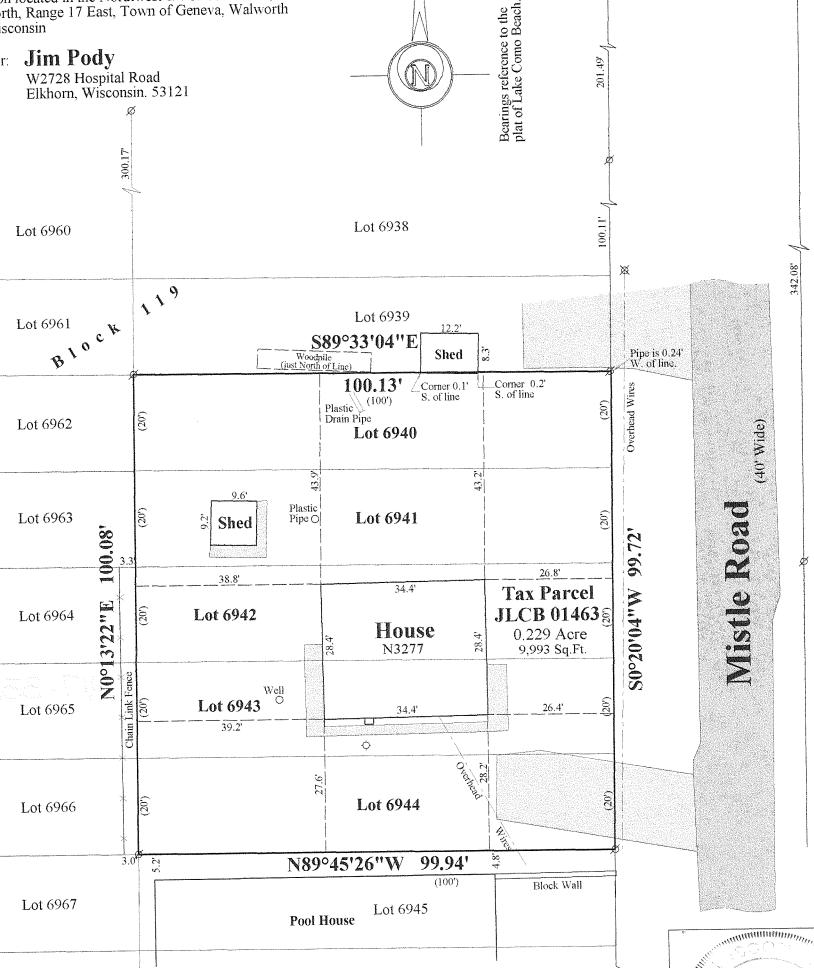


Copyright c 2006 by Jensen & Olson Land Surveying, LLC.

All rights reserved. No part of this survey plat may be reproduced or transmitted in any form by any means - graphic, electronic, or mechanical, including photocopying, tracing, or information storage and retrieval systems - without permission in writing from Douglas G. Olson, Jensen & Olson Land Surveying, LLC.

I, Douglas G. Olson, Wisconsin Registered Land Surveyor, do hereby certify that this survey was performed by me or under my direction in full compliance with the owner's/agent's instructions and Chapter A-F-7 of the Wisconsin Administrative Code "Minimum Standards for Property Surveys"; and that this map is an accurate representation thereof to the best of my knowledge and belief.

> Douglas S. Olson Wisconsin Registered Land Surveyor - 2093



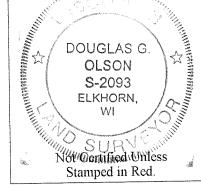

- **Notes:** 1) This survey plat is not certified unless signed and sealed in red ink.
 - This survey is subject to Wisconsin lien laws. This Plat of Survey is the notice of intent to file lien. Lien waiver required.

Legend

- Found Iron Pipe Found P.K. Nail
- Recorded Information Utility Pole
 - PVC Pipe Asphalt Surface Concrete Surface

B-1460

Jensen & Olson Land Surveying, LLC

45 South Wisconsin Street P.O. Box 322 Elkhorn, Wisconsin. 53121

Telephone: (262) 723-3434 Facsimile: (262) 723-8044

10'

20'

Scale: 1'' = 20'40' Survey date: September 19, 2006. Revisions:

Sheet 1 of 1 Sheets.

Job Reference Number:

 60° $\frac{17-3336}{2006.111}$