



CHUCK AND MARILYN
HAMPTON RESIDENCE

WORK ORDERED BY
MATT JOHNSON - SUPERB BUILDERS, LLC
5516 STATE ROAD 11
ELKHORN, WI 53121

FARRIS, HANSEN & ASSOCIATES, INC.
Engineering, Architecture, Surveying
7 Ridgeway Court P.O. Box 437
ELKHORN, WISCONSIN 53121
Office: (262) 723-2098
Fax: (262) 723-5886

REVISIONS
08/24/2006
SITE, GRADING,
DRAINAGE, AND
EROSION
CONTROL PLAN
09/25/2006
REVISED SIZE
OF PROPOSED
RESIDENCE
10/05/2006
MISC. REVS.
TO GRADING
AND CULVERTS
01/02/2007
TO SHOW SIZE
AND LOCATION
OF AS-BUILT
FOUNDATION

PROJECT NO.
3269.15.37
DATE:
06/13/03
SHEET NO.
1 OF 1

AS-BUILT MAPPING PLAT OF SURVEY

UNIT 15-37
GENEVA NATIONAL CONDOMINIUM
NO. 15

LOCATED IN TOWN 2 NORTH, RANGE 17 EAST
WALWORTH COUNTY, WISCONSIN

BENCH MARK
RIM SANITARY
MANHOLE
ELEV.=1042.32'

GENEVA NATIONAL AVENUE
66' WIDE PRIVATE ROADWAY

EXISTING WATER
AND SEWER SERVICES
(VERIFY GRADE IN FIELD)

EXISTING 8"
SANITARY SEWER

EXISTING 12"
WATERMAIN

S 64° 29' 20" E
C=114.37
A=114.73
R=418.00

25' STREET YARD

CITY BOX
ELEV.=1042.32'

PLASTIC LANDSCAPING
0.5' +/- EAST OF LOT
LINE

UNIT 15-38

AS-BUILT
FOUNDATION

T.F.=1043.9'
(FIELD LOCATED
12/29/2006)

UNIT 15-37
19,200 S.F.


N 53° 32' 18" W

87.16

50' GOLF CLUB GROUNDS SETBACK


GOLF CLUB GROUNDS

CART PATH

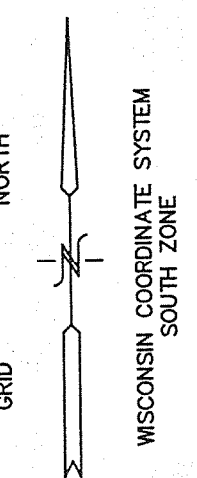

LEGEND

- = FOUND IRON REBAR STAKE
- (xxx) = RECORDED AS

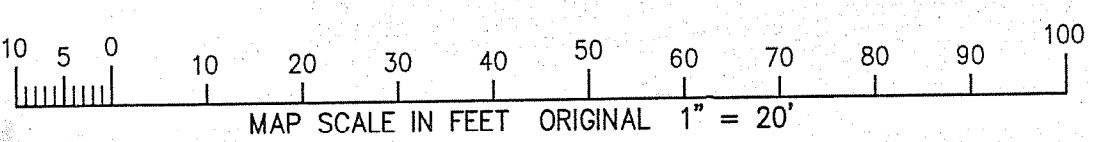

NOTE: COPIES OF THIS MAP TO WHICH THE FOLLOWING CERTIFICATE WILL APPLY SHOW SURVEYOR'S ORIGINAL SEAL AND SIGNATURE IN RED INK. COPIES BY ANY OTHER MEANS MAY HAVE ALTERATIONS WHICH DO NOT REPRESENT THE SURVEYOR'S WORK PRODUCT.

I HEREBY CERTIFY THAT THE ABOVE DESCRIBED PROPERTY HAS BEEN SURVEYED UNDER MY DIRECTION AND THAT THE ABOVE MAP IS A TRUE REPRESENTATION THEREOF AND SHOWS THE SIZE AND LOCATION OF THE PROPERTY AND ITS EXTERIOR BOUNDARIES. THIS SURVEY IS MADE FOR THE USE OF THE PRESENT OWNERS OF THE PROPERTY, AND ALSO THOSE WHO PURCHASE, MORTGAGE, OR GUARANTEE THE TITLE THERETO WITHIN ONE YEAR FROM THE DATE HEREOF.

DATED: 06/13/2003



PETER S. GORDON
S-2101
ELKHORN, WI

JCN 15-37

217-3348